


50/967  
 A11  
 SEC 14


PIHTA  
 JAMES

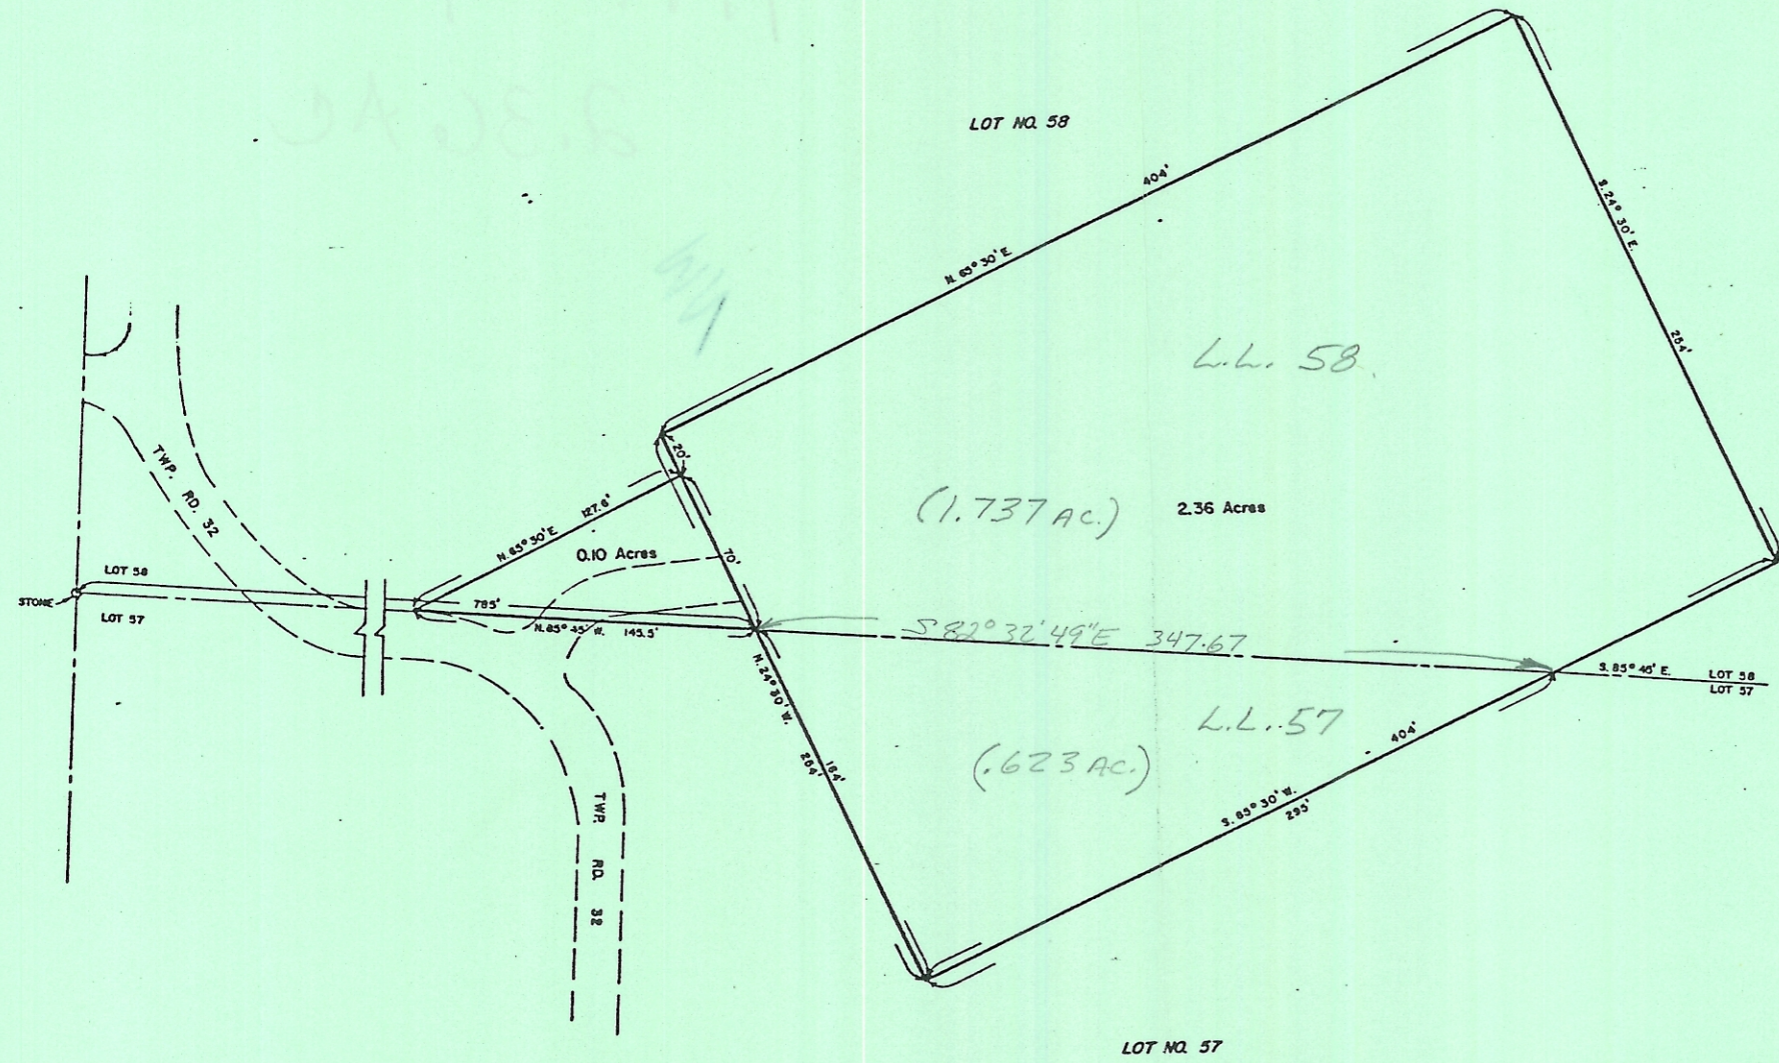

68.68  
 2.46  
 66.22

PLAT OF  
 ELLIOTT SUBSTATION NO. 113 SITE

ATHENS TOWNSHIP OHIO ATHENS COUNTY  
 COLUMBUS AND SOUTHERN OHIO ELECTRIC COMPANY

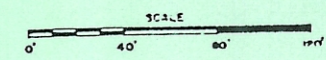

DESCRIPTION	GRANTOR	GRANTEE	D. B.	PAGE	DATE	COMPANY PARCEL NO.
2.47 Acres	STATE OF OHIO	COLS & SQ. OH. EL. CO.	313	667	FEB. 12, 73	15 YR. LEASE