

GUTHRIE
346-697

N 83° 34' 50" E
360.62'

LOT 32

N 31° 27' W
121.04'

Beechwood Drive

N 85° 32' 27" E
202.53'

159.24'

PARCEL "A"

PARCEL "B"

BEECHWOOD DRIVE
LC = N 63° 19' 52" W 155.99'
R = 325.13'

LOT 31

WETZEL
345-859

Iron Pins not set unless specified thus: I.P. Set - o

I hereby certify that the foregoing plat was prepared from an actual survey of the premises and correctly shows the location of buildings and drives. This plat is prepared for mortgage loan and title purposes only and is not to be construed as having been prepared for the owner or for the use of the owner for any purpose.


County: ATHENS P.B. Pg. 57 D.B. 342

Subdivision: BEECHWOOD LAKE ESTATES

Buyer: MICHAEL ROBERSON Date: 4-20-83 Scale 1" = 50'

Property Address: 288 BEECHWOOD DRIVE, ATHENS, OHIO

GREGORY K. WRIGHT

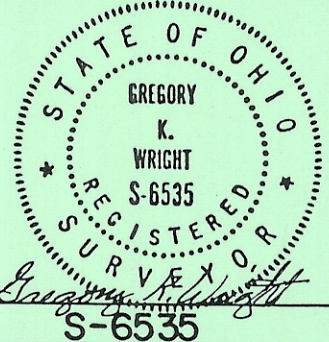

S-6535