



C. Thomas Smith
Ohio Professional Surveyor
P.O. Box 393
Racine, Ohio 45771
740-949-2524

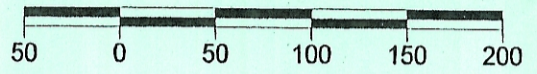

Being a part of Lease Lot 129, Section 27,
Township-9-North, Range-14-West, Athens
Township, Athens County, Ohio.

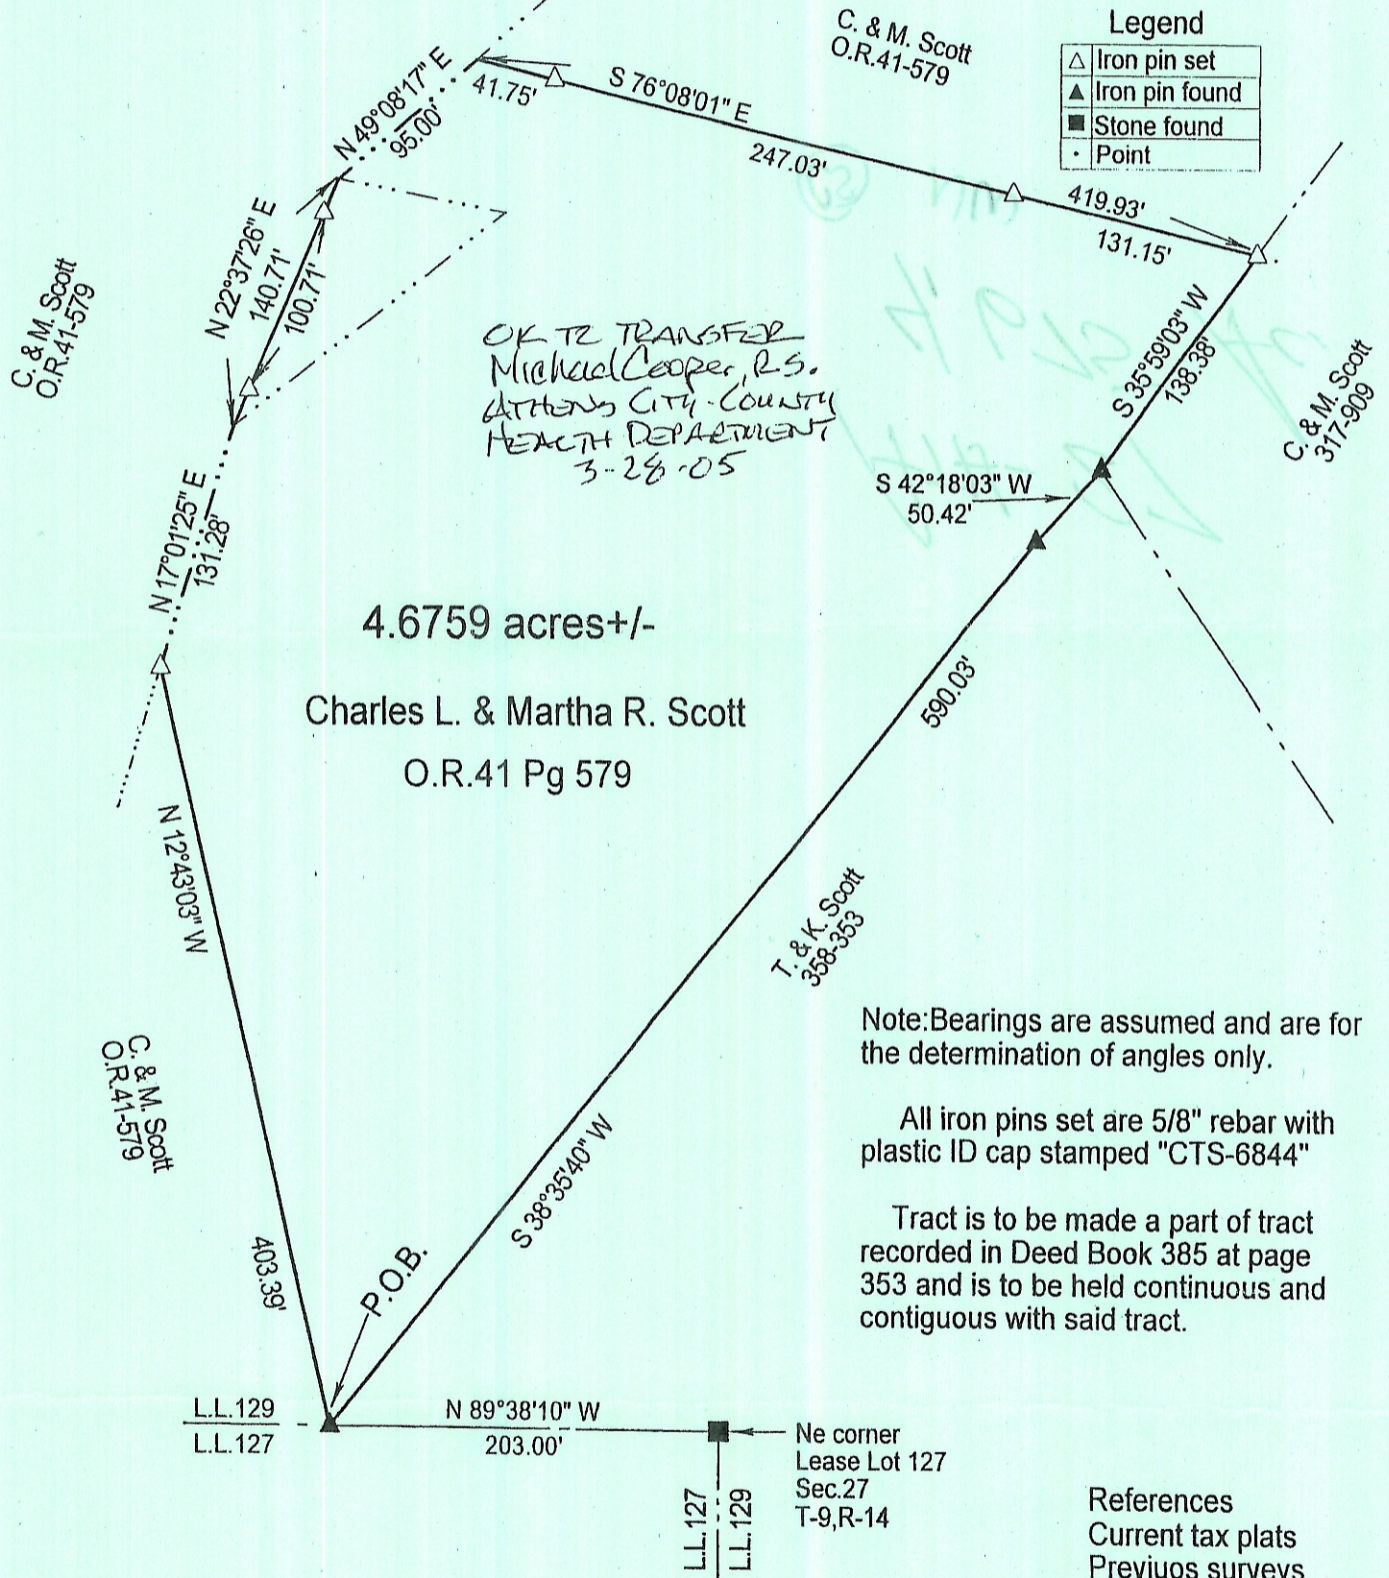

OK TO TRANSFER
Michael Cooper, P.S.
Athens City-County
HEALTH DEPARTMENT
3-28-05

4.6759 acres +/-

Charles L. & Martha R. Scott
O.R.41 Pg 579

Note: Bearings are assumed and are for the determination of angles only.

All iron pins set are 5/8" rebar with plastic ID cap stamped "CTS-6844"

Tract is to be made a part of tract recorded in Deed Book 385 at page 353 and is to be held continuous and contiguous with said tract.

References
Current tax plats
Previous surveys
Deeds: as noted

Plat prepared from an actual survey made on the
18th day of March, 2005 by,

C.T.R. Smith

Ohio Professional Surveyor

No. 6844

Description Checked for
Mathematical Accuracy
Athens County
ENGINEER'S OFFICE

BY: *S. Blaus*
DATE: 3-22-05

Exhibit B