

139

139

138

ROGER L. & JUDY L. STOVER
352-479
2.00 AC.

WALTER BABICS JR.
378-367
15.95 AC.

TRACT B
16.44 AC.

KATHRYN WALBURN
288-191
34.46 AC. - DEED

TRACT A
15.55 AC.

KATHRYN WALBURN
282-122.125
58.5 AC.

RICHARD PERRY
217-504 374-355
364-937

EDNA & MARIE WARD
204-496 51.11 AC.

PLAT OF SURVEY OF:
TRACT A - 15.55 AC.
TRACT B - 16.44 AC.



SITUATED IN LEASE LOT 139, SECTIONS 28, AND 29, TOWN 9
RANGE 14, ATHENS TOWNSHIP, ATHENS COUNTY, OHIO

PREPARED BY:
SOUTHEASTERN LAND SURVEYS

OCTOBER 19, 1994

FOR: KATHRYN WALBURN

LEONARD F. SWOYER, P.S. 6765

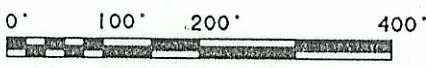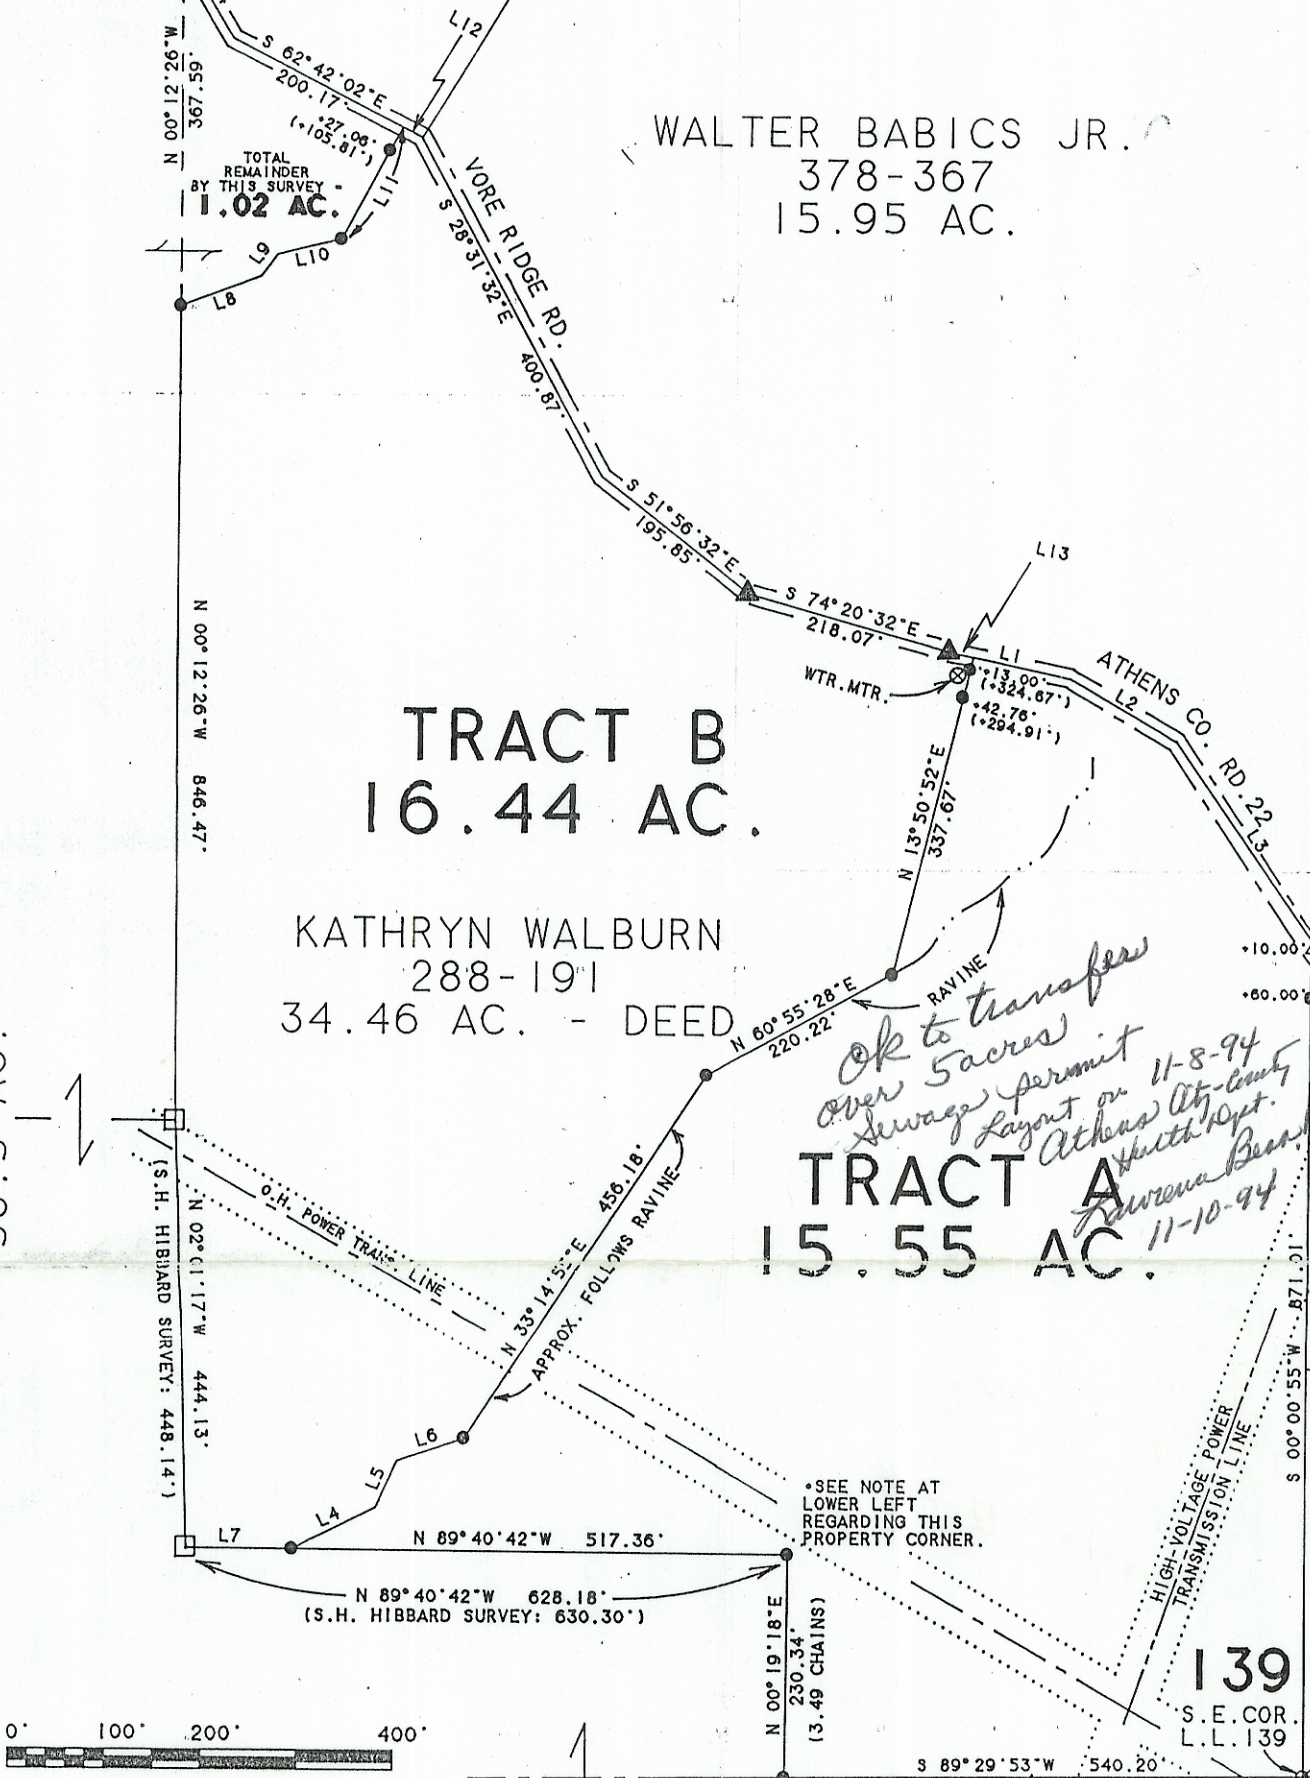

SCALE: 1" = 200'

- - I.P. FD. Δ - R.R. SPIKE SET
- - I.P. SET
- - STONE FD.
- ▲ - RAILROAD SPIKE FD.
- ◇ - SPIKE NAIL FD.

LINE	BEARING	DISTANCE
L 1	S 77° 58' 19" E	103.63'
L 2	S 60° 18' 02" E	128.69'
L 3	S 34° 59' 02" E	248.05'
L 4	N 63° 26' 25" E	96.43'
L 5	N 23° 56' 14" E	53.13'
L 6	N 71° 45' 55" E	73.61'
L 7	N 89° 40' 42" W	110.82'
L 8	N 69° 40' 44" E	89.25'
L 9	N 35° 44' 10" E	28.85'
L 10	N 76° 16' 29" E	68.42'
L 11	N 28° 12' 33" E	132.87'
L 12	S 62° 42' 02" E	22.86'
L 13	S 77° 58' 19" E	25.47'
L 14	S 31° 10' 32" E	102.92'

