


SOUTH CONGRESS STREET

(66.0' RW)

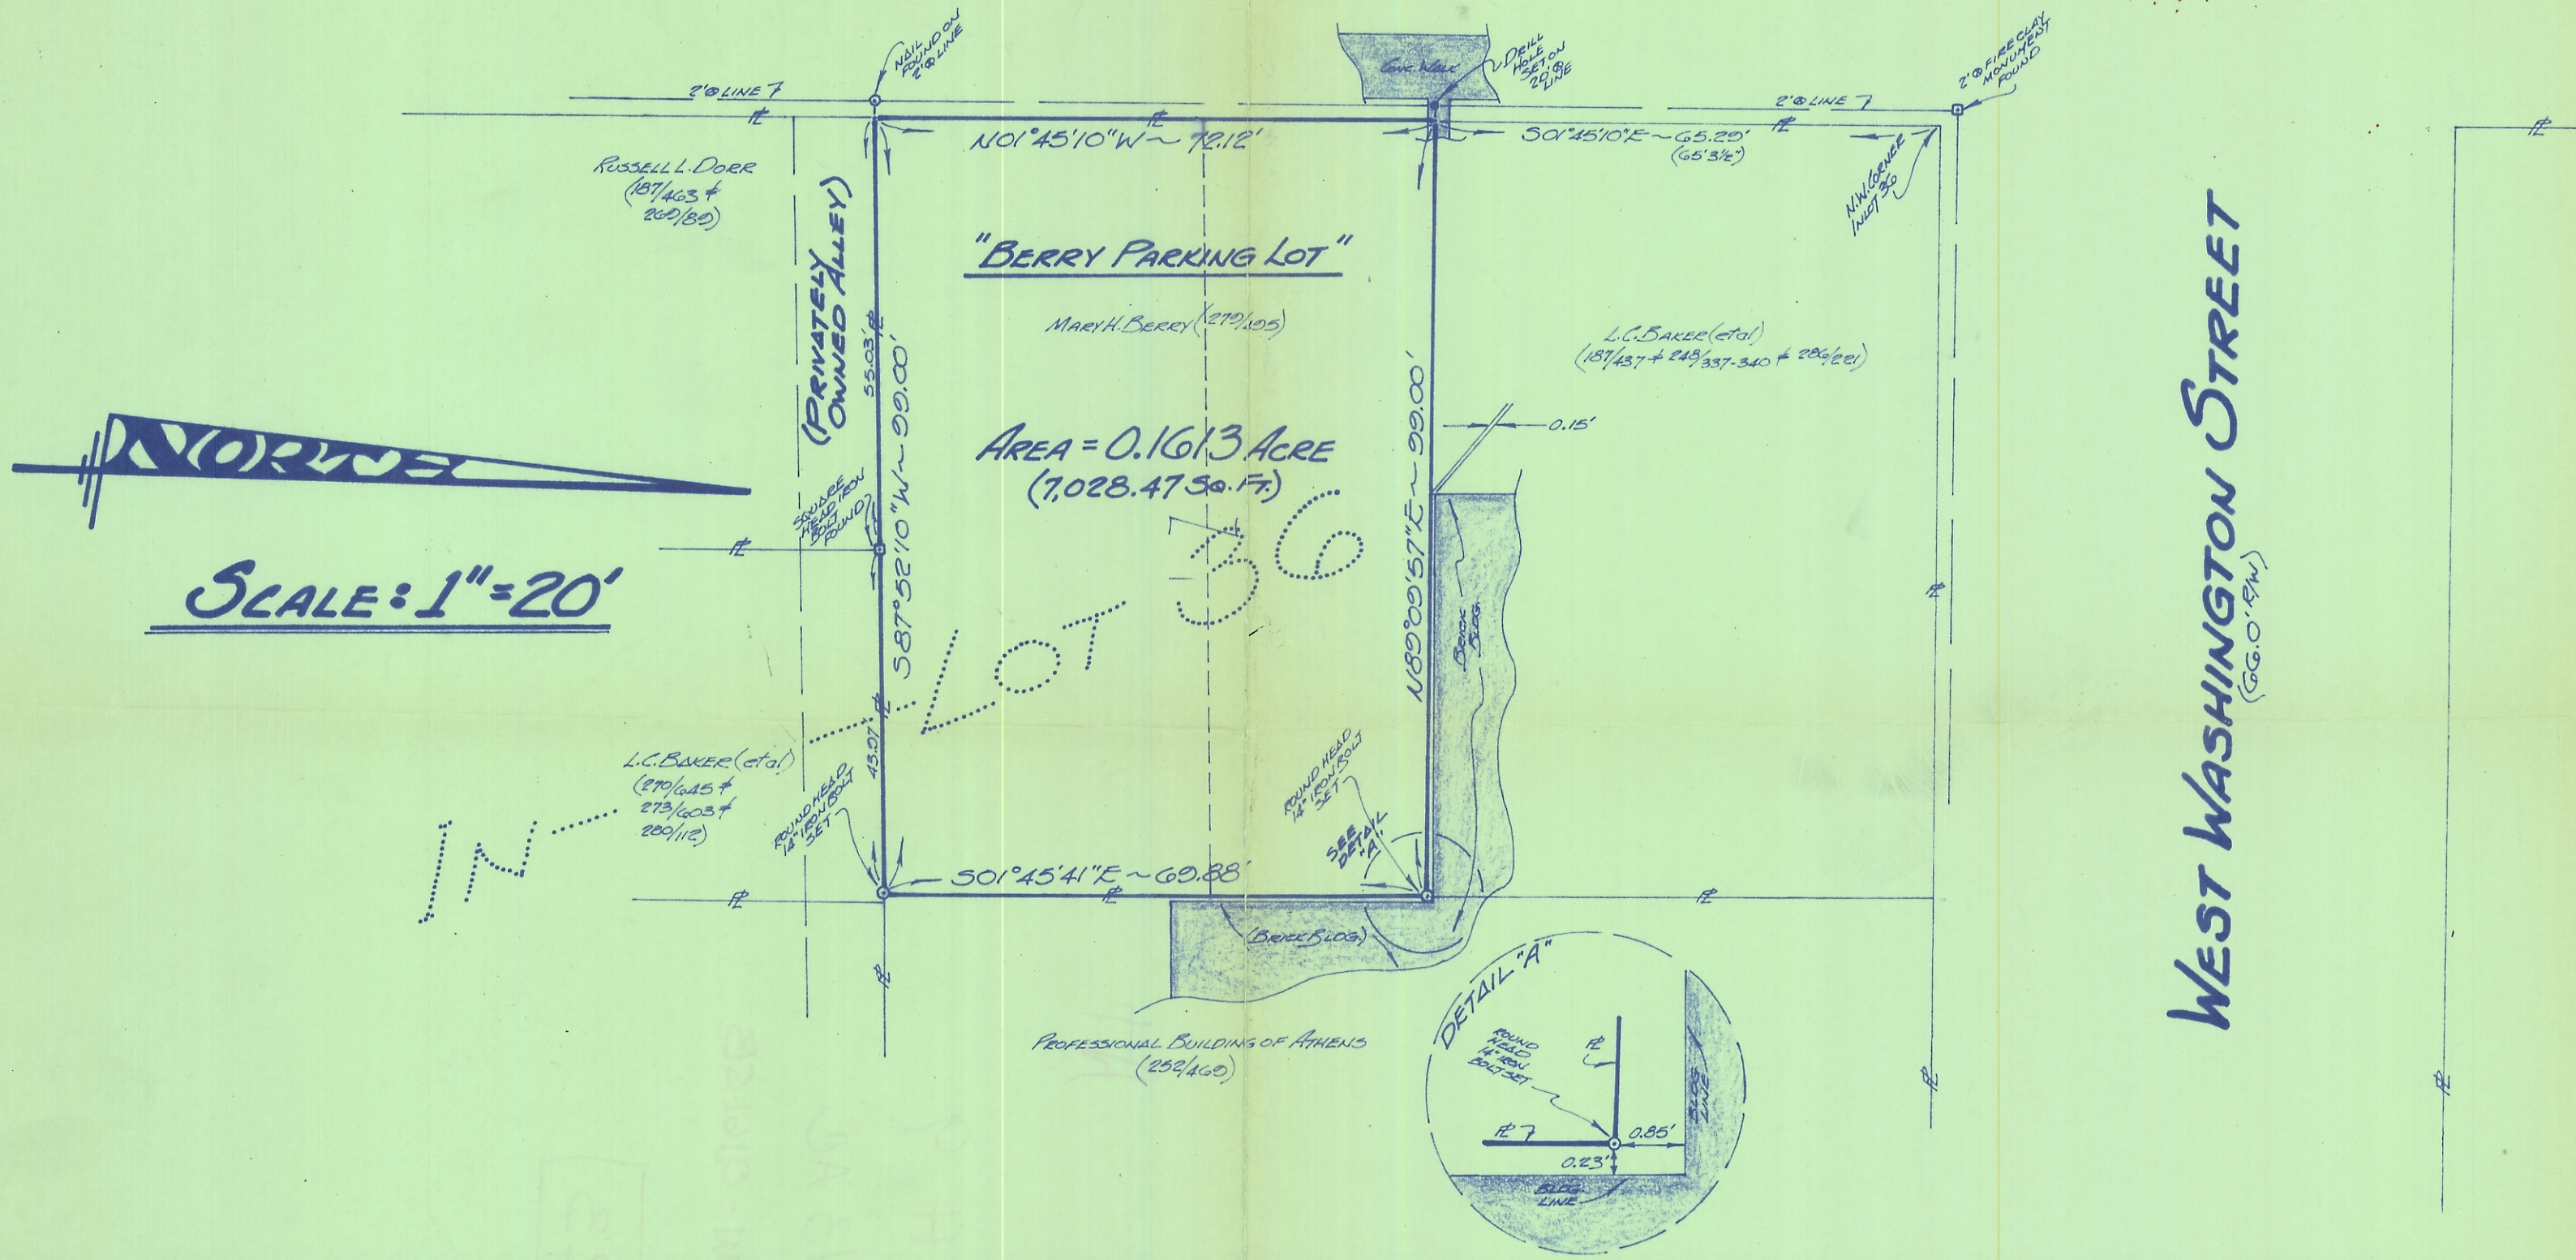

WEST WASHINGTON STREET
(66.0' RW)

FOR: **ATHENS COUNTY BOARD OF COMMISSIONERS**
ATHENS COUNTY COURT HOUSE
ATHENS, OHIO - 45701

BY: **GERALD W. BAYHA, P.S.**
REGISTERED PROFESSIONAL SURVEYOR No. S-6139
Route No. 5 ~ Box No. 204
(PLEASANT HILL) ATHENS, OHIO - 45701 ~ (614) 592-4398

PLAT OF SURVEY

OF A SOUTHWESTERLY PART OF INLOT No. 36 ~ SECT. 9 ~ TOWN 9 ~ RANGE 14 ~ ATHENS CITY ~ ATHENS TOWNSHIP
ATHENS COUNTY ~ OHIO ~ U.S.A.

DRAWN	CHECKED	REVISIONS	DATE	JOB No.
GB	GB		7 JUNE '77	# 577-10

SHEET No.

Gerald W. Bayha, P.S.