

Plat of Brooksville.


Situated in Lease Lots N^{os} 139, - 176 and 179.

Town N^o 9 Range N^o 14 O.U.L.

scale 1 inch to 66 Feet

Athens County Ohio.

ENVELOPE: 154A
BROOKSVILLE
ATHENS TWP

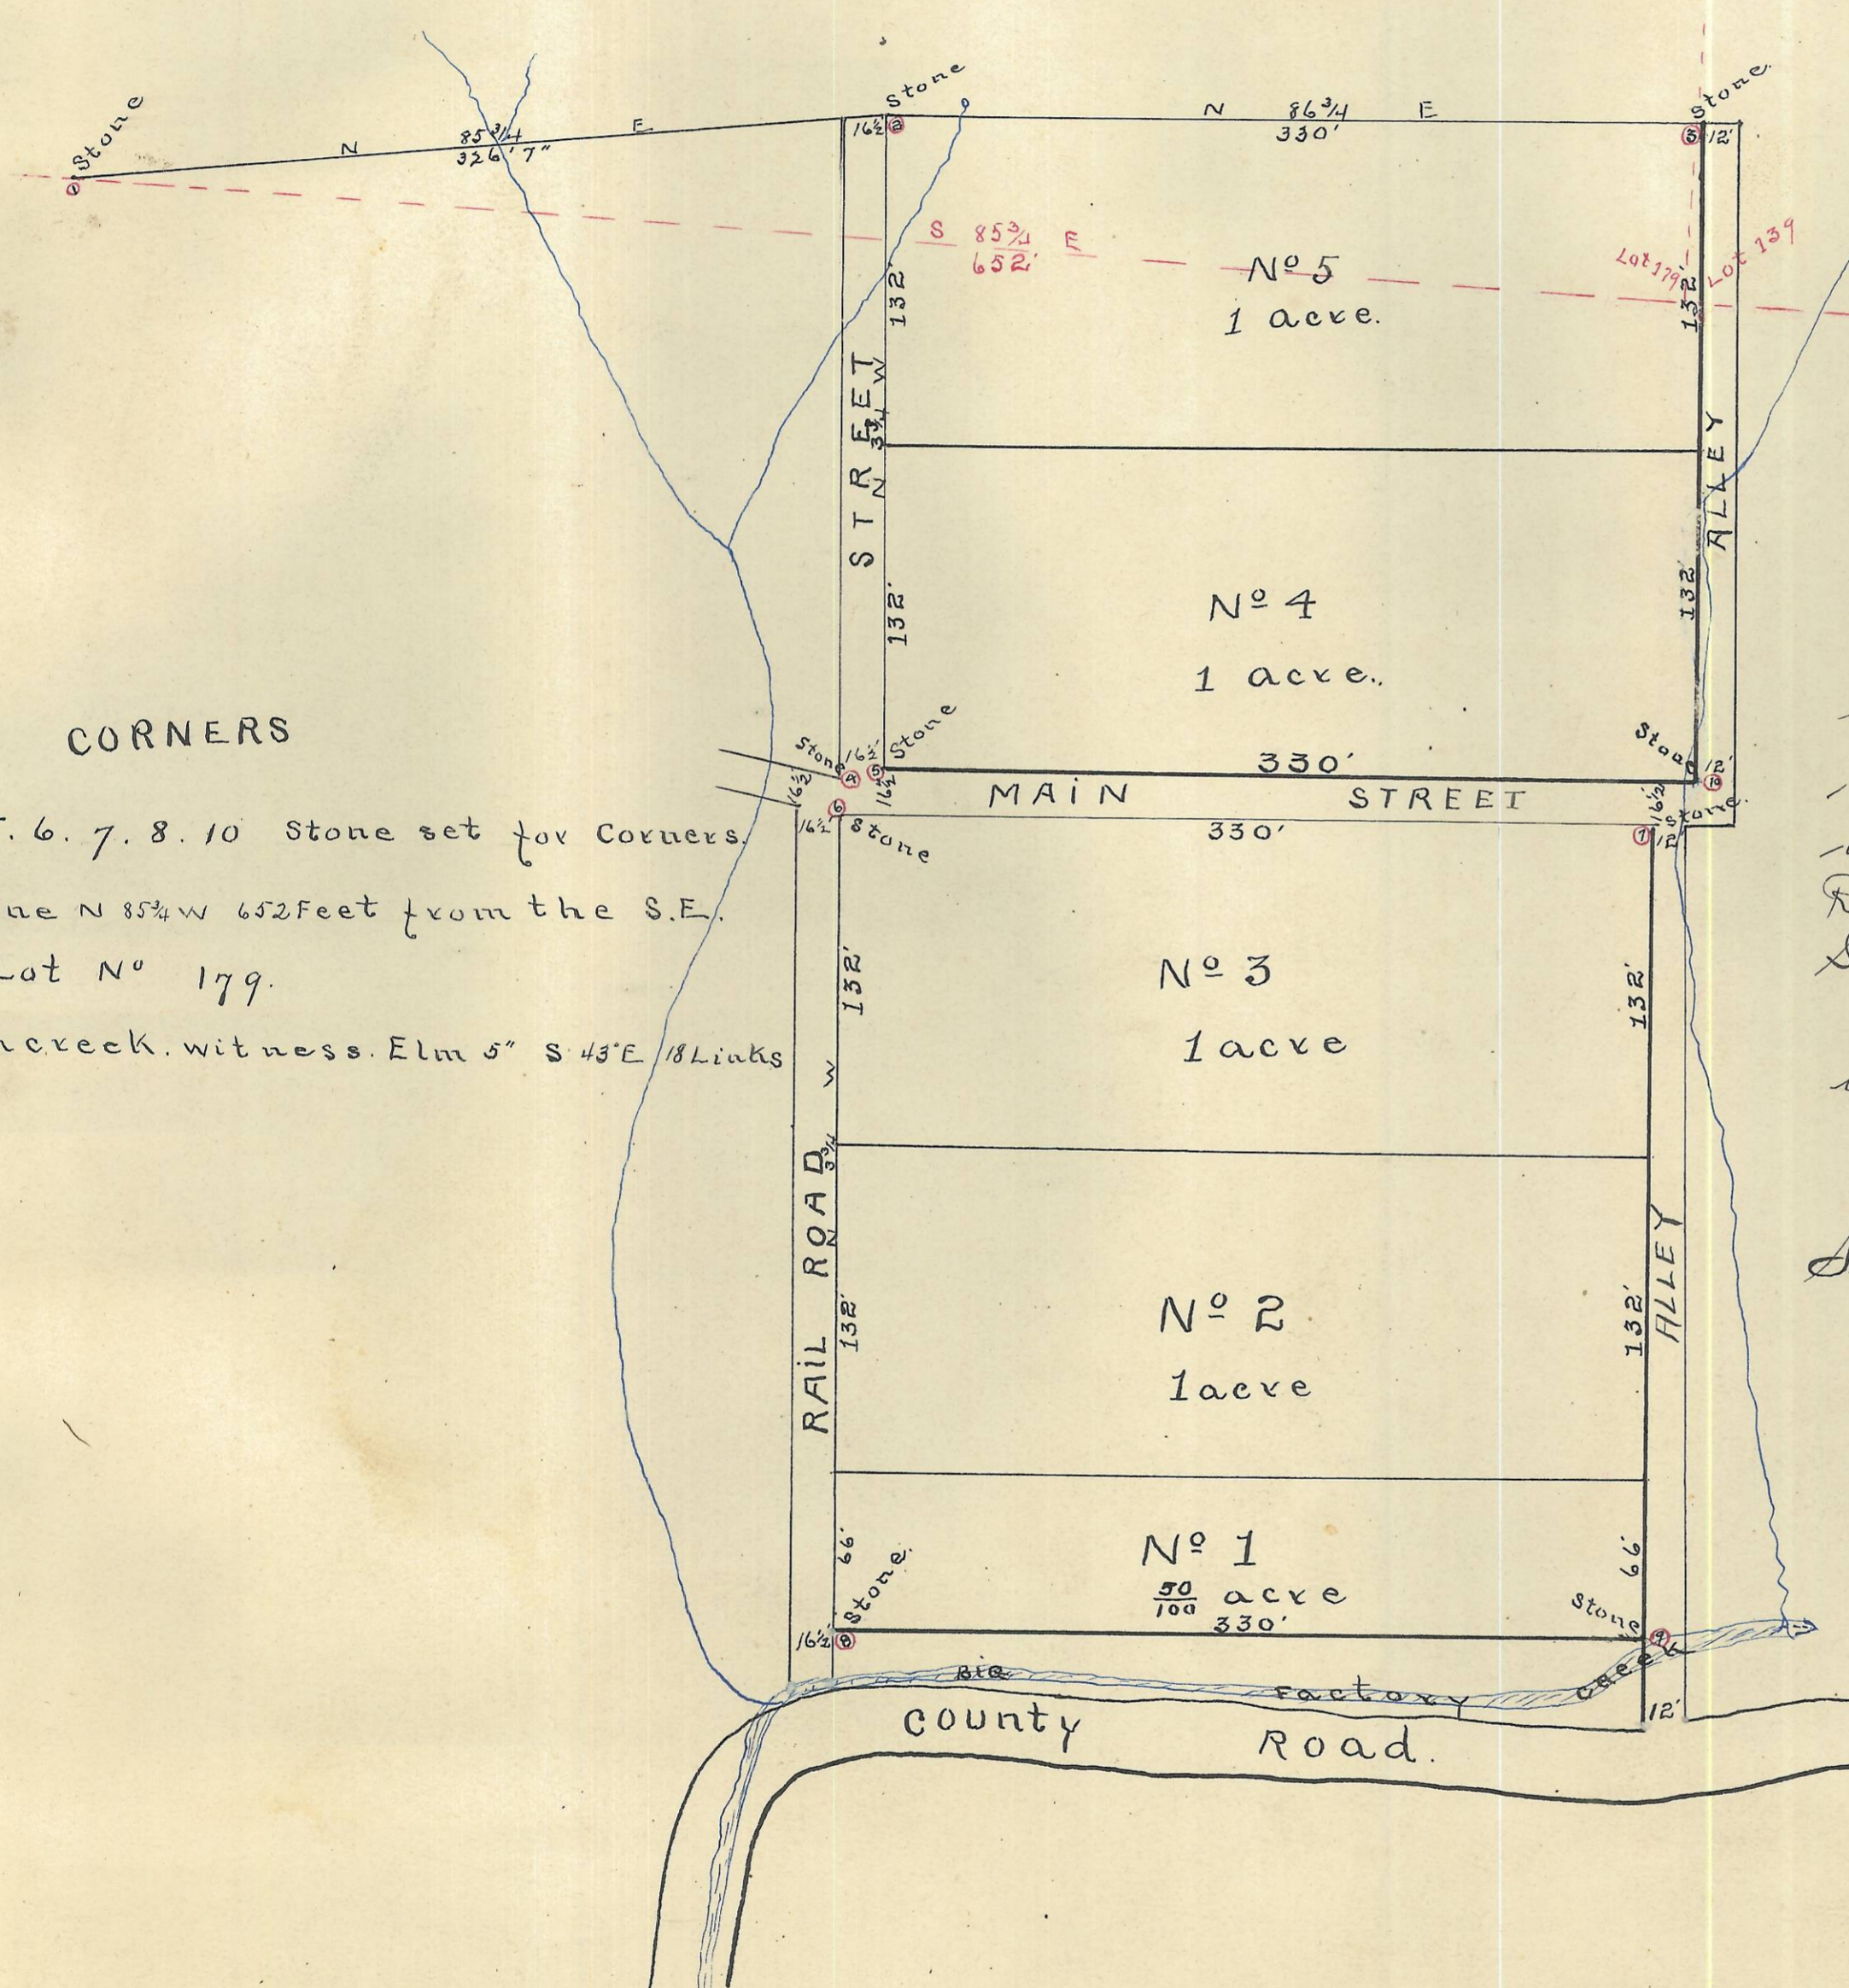

CORNERS

- N^{os} 2, 3, 4, 5, 6, 7, 8, 10 Stone set for Corners.
- No 1 Old stone N 85³/₄ W 652 Feet from the S.E. Corner of Lot N^o 179.
- N^o 9 Stake in creek. witness Elm 5" S 43^o E 18 Links

Athens Ohio, March 31st 1897.

I Hereby certify the foregoing plat & Notes to be correct.

J.R. Sands,
Surveyor

Know all men by these presents,
That I Annie E. Hibbard the
owner of the lands delineated on this plat, do hereby
acknowledge the making of the same to be my voluntary
act and deed for the use and purpose therein expressed.
Ratify the said survey as therein given and dedicate the
Streets and Ways shown thereon to public use forever.
In witness whereof I have hereunto set my hand this 31st day of March 1897, Annie E. Hibbard
In the presence of us J.R. Sands
S. H. Hibbard

State of Ohio Athens County ss.
Be it remembered that on this 2^d
day of April 1897. Before me the
County Surveyor in and for said County personally
came Annie E. Hibbard the grantor in the foregoing
deed of dedication and acknowledged the signing thereof
to be her voluntary act for the uses and purposes
therein mentioned.
In testimony whereof I have hereunto subscribed my name officially
S. H. Hibbard,
County Surveyor.

Transferred April 3^d 1897.

W. F. Scott
Aud
E

Received April 13th 1897, at 2 P.M.
Recorded April 17th 1897
Attest C. L. Bean, Recorder.
By Wm. Light, Deputy.