


ENVELOPE: 219B
CAMPBELL'S ADDITION
COOLVILLE

10 Rods to the inch

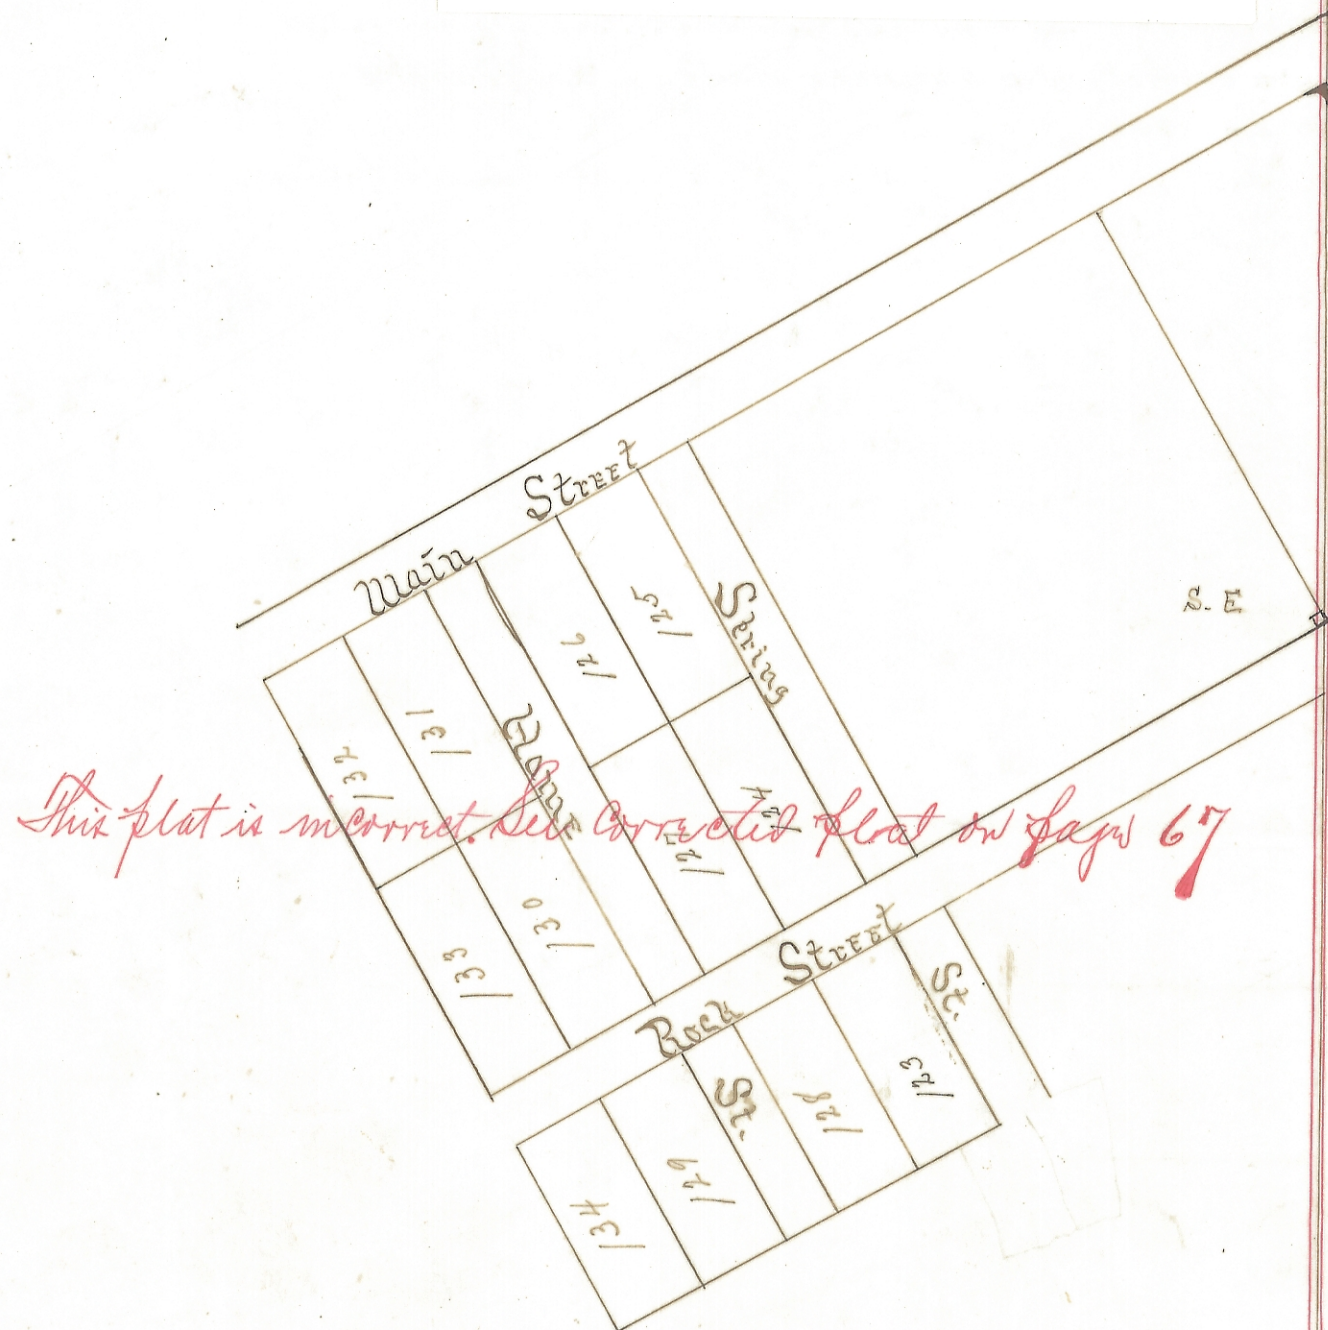

Campbell's Addition to Coolville Ohio.

Coolville O. May 10-1907.

This is to certify that G. K. Campbell's addition of lots # 99-100-101-102-103-104-105-106 and O.L. # 33-34-35 + 36 as surveyed and plotted by S. I. Mitchell on the 3rd day of May 1907 was duly accepted by the village council at its regular session of May 6-1907.

Attest: A. C. Davis
Clerk

F. S. Monahan
Mayor

May 3rd 1907

The description of attached plat of an additional 12 lots to the village of Coolville, Athens Co. Ohio, as follows to-wit: Beginning at a point 26 rods south 60° west (on west side of Spring St.) of a stone at the south east corner of lot no. 89 of the village of Coolville known as the "Seminary Lot" thence in the same direction 23 rods to the southwest corner of lot no. 106, thence north 30° W. 24 rods to the northwest corner of lot no. 105, thence north 60° east 23 rods to the northeast corner of lot no. 100, thence south 30° east 24 rods to the place of beginning containing 8 lots. Each lot containing 60 sq. rods (or 5 x 12 rods). Also the following to-wit: Beginning at a point south 30° east 3 rods from the southeast corner of lot no. 99, thence south 30° east 12 rods to the southeast corner of out lot no. 33, thence south 60° west 23 rods to the southwest corner of out lot no. 26, thence north 30° west to the northwest corner of said lot 12th, thence south 60° east 22 rods to northeast corner of lot no. 23, place of beginning, containing (4) four lots each lot containing 60 sq. rods (or 5 x 12 rods).

Witness: F. B. Tidd
J. M. Tidd

S. I. Mitchell
Surveyor.

State of Ohio, Athens County ss.

Personally appeared before me a Notary Public in and for said county, S. I. Mitchell who makes oath that the within plat and description is correct. Signed this 9th day of May 1907.

[Signature] Frank B. Tidd

Know all men by these presents: That the undersigned owners of lands described in this plat, do hereby acknowledge the same to be our voluntary act and deed and do hereby dedicate the streets and alleys to public use forever.

In Testimony Whereof I hereunto set my hand and seal this 6th day of Sept. 1907.

G. K. Campbell

The State of Ohio, Athens County ss.

Subscribed and sworn to before me this 6th day of September 1907.

[Signature] A. W. Lynch
Probate Judge

Transferred 9/6/07
E. R. Walker
Auditor

Recd. for record Sept 6-1907
at 11th A. M.
Recorded Sept. 14-1907

W. P. Richards
Recorder