


CANAAN TWP.  
FRACTIONS 17 & 23, & SECTION 16, T5N, R13W

QUANTITIES	FED. RD. DIVISION	STATE	PROJECT	602
CALCULATED BY: KO	5	OHIO		656
CHECKED BY: JC				

ATHENS COUNTY  
ATH-50-18.54

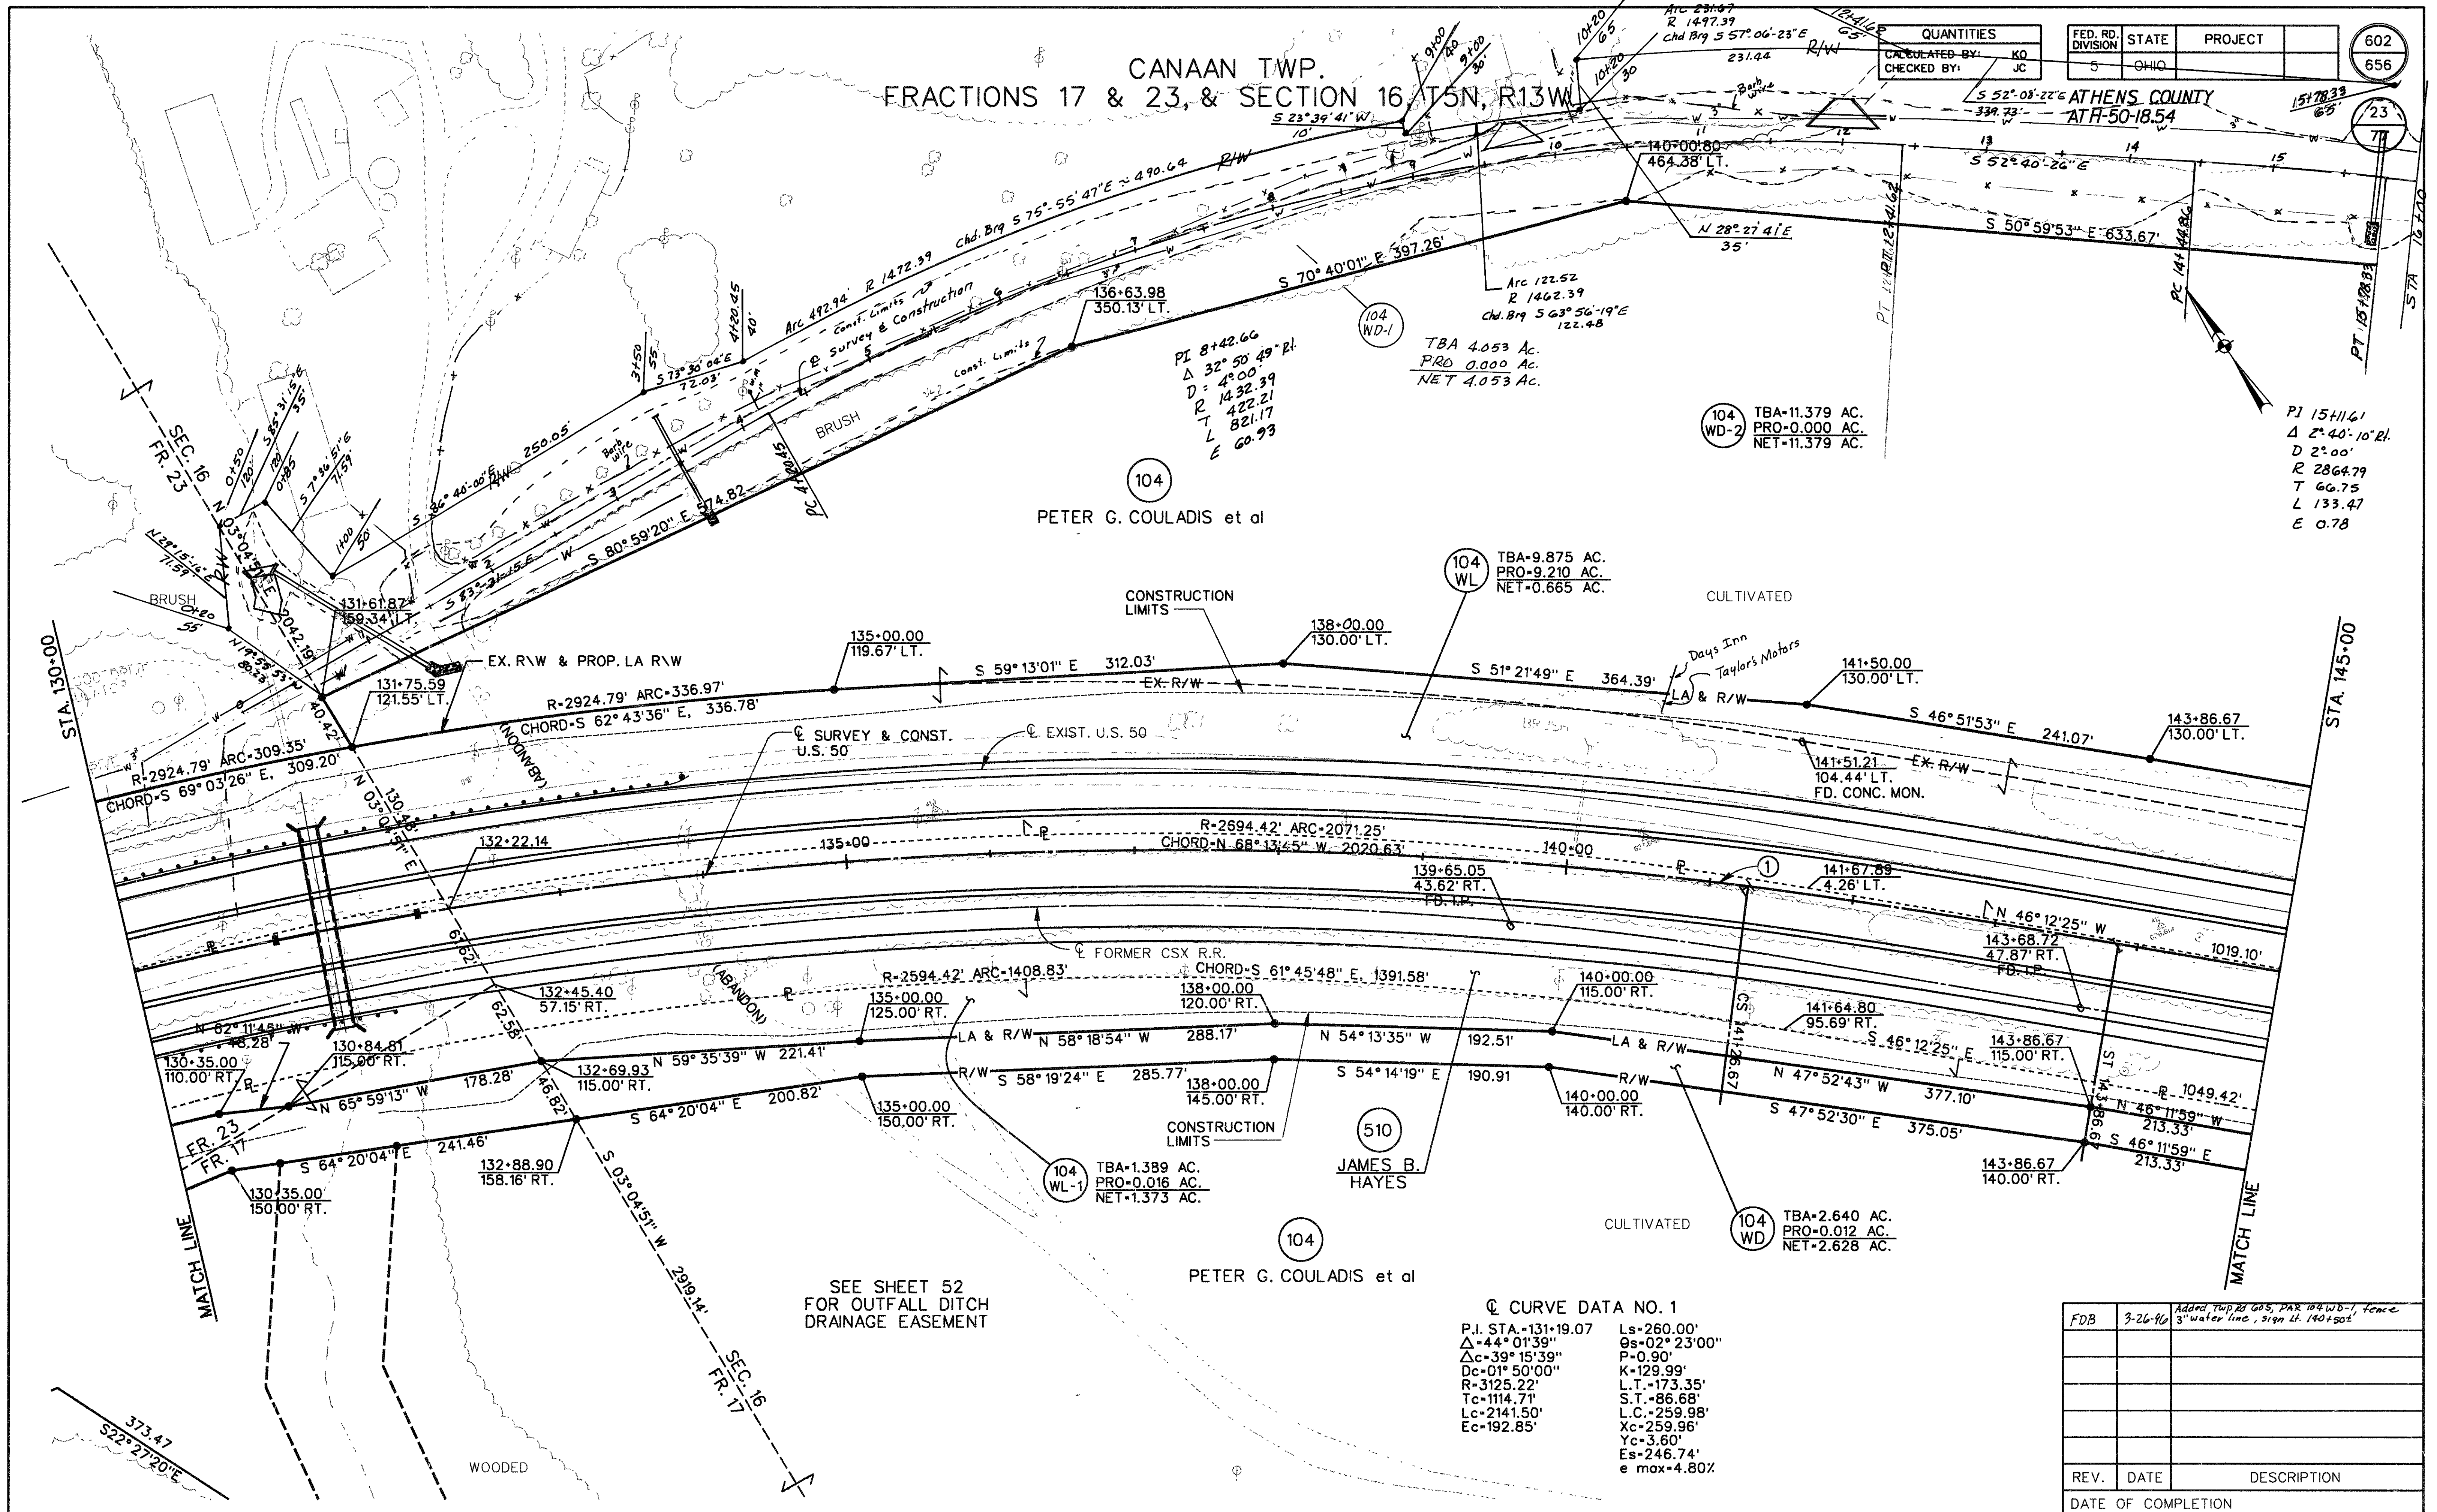

104  
PETER G. COULADIS et al

104 WL-1  
TBA-1.389 AC.  
PRO-0.016 AC.  
NET-1.373 AC.

510  
JAMES B. HAYES

104  
PETER G. COULADIS et al

☉ CURVE DATA NO. 1  
P.I. STA.=131+19.07  
Δ=44° 01' 39"  
Δc=39° 15' 39"  
Dc=01° 50' 00"  
R=3125.22'  
Tc=1114.71'  
Lc=2141.50'  
Ec=192.85'  
Ls=260.00'  
Os=02° 23' 00"  
P=0.90'  
K=129.99'  
L.T.=173.35'  
S.T.=86.68'  
L.C.=259.98'  
Xc=259.96'  
Yc=3.60'  
Es=246.74'  
e max=4.80%

FDB	3-26-90	Added Twp RI 605, PAR 104 WD-1, fence 3' water line, sign 14' x 50'
REV.	DATE	DESCRIPTION
DATE OF COMPLETION		