



SURVEY OF A 0.85 ACRE TRACT
 IN SECTION 1, T.5, R.13, CANNON
 TOWNSHIP, ATHENS Co, OHIO
 SURVEYED JULY 1989

John M. Branner
 JOHN M. BRANNER P.S. 6805

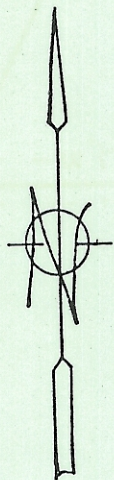

SCALE: 1"=50'
 O = IRON PIN SET
 ▽ = RDS SET

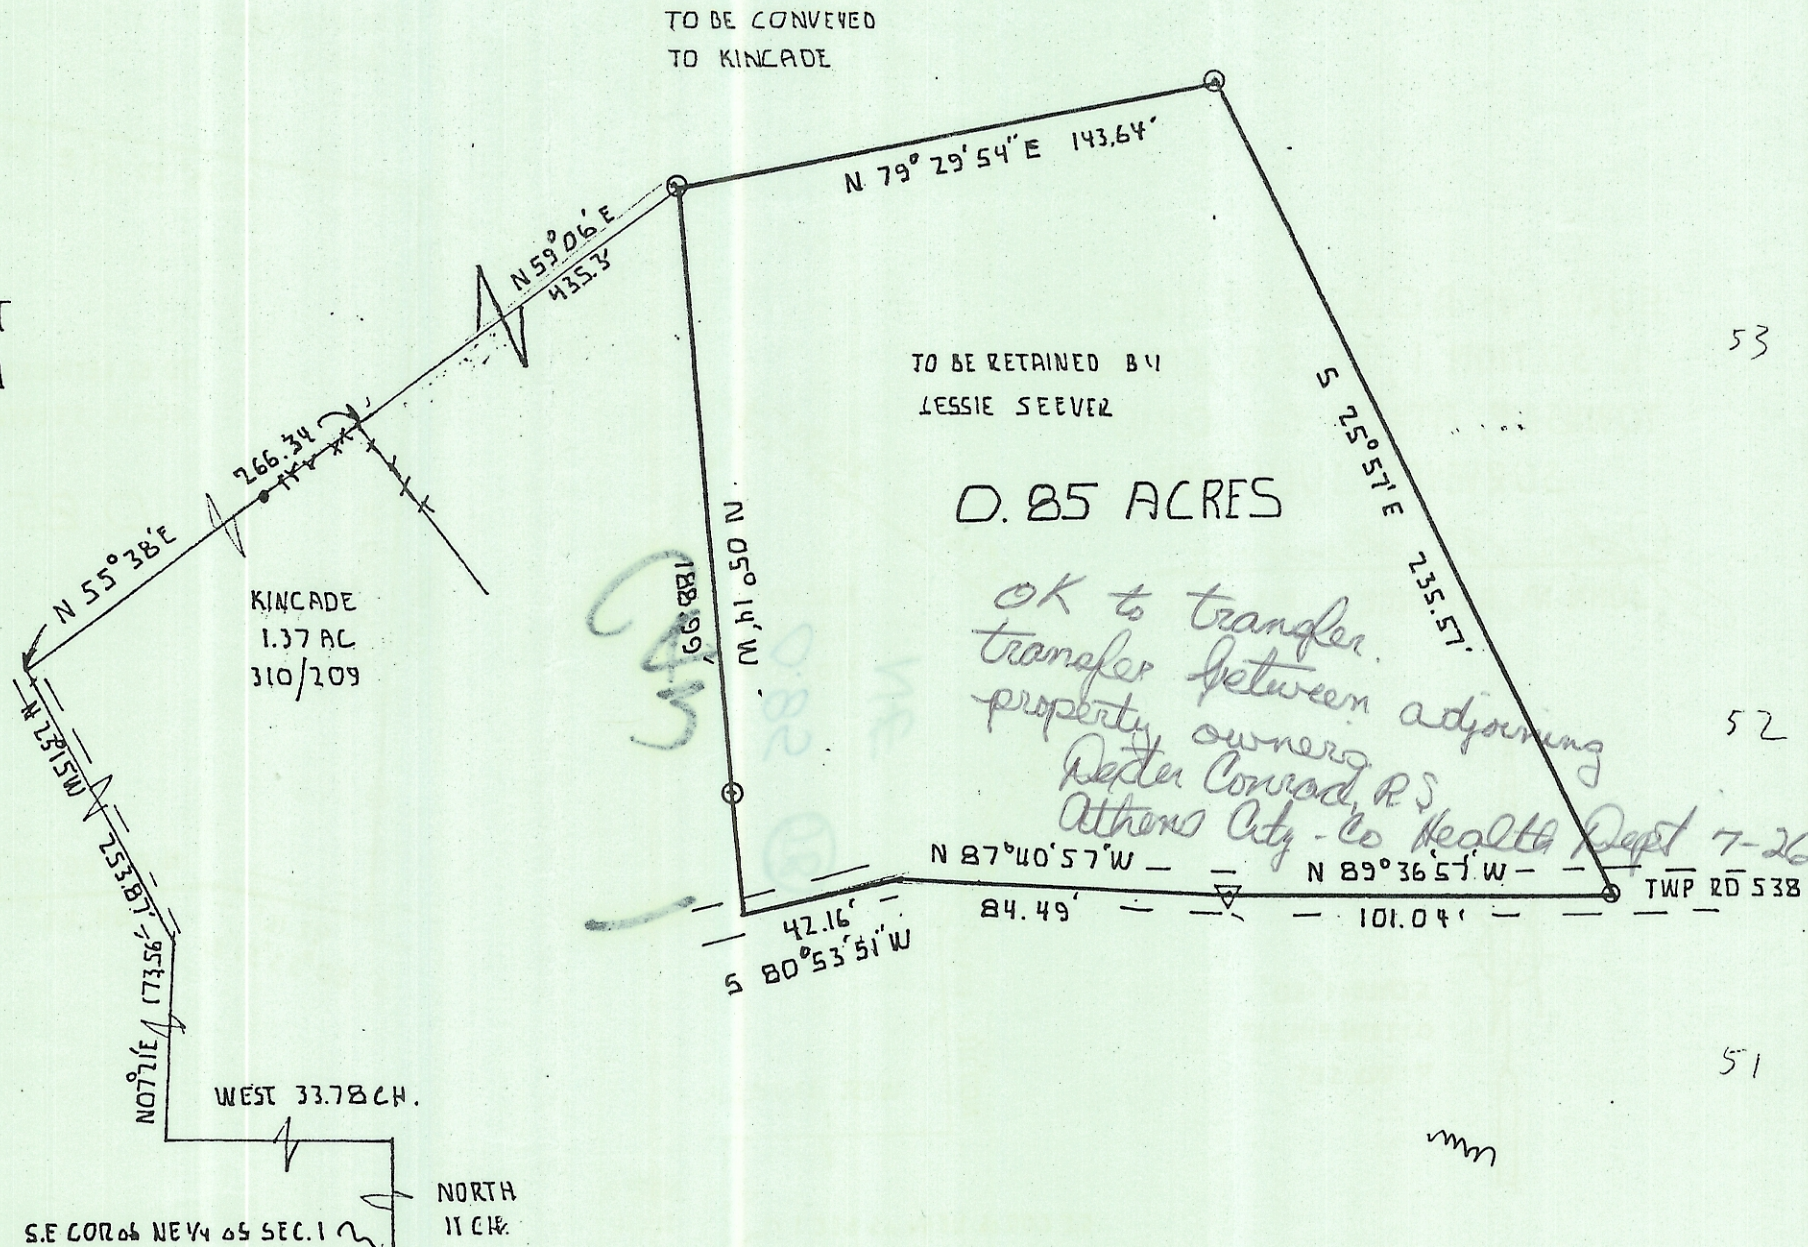

54

53

52

51

46

47

48

49

50