


PLAT of SURVEY

Canaan Township, Athens County, State of Ohio.
 Part Fraction #24 in the S.W. Quarter of Sec. 28,
 Twp.-5N, Rng.-13W, Ohio Company Purchase.

Prepared By:

PIN 2005 1687-05ATH

S.A. ENGLAND ASSOCIATES
 PROFESSIONAL LAND SURVEYING
 P.O. BOX 1770 (5179 WALNUT RD.)
 BUCKEYE LAKE, OHIO 43008
 740-928-8680 FAX 740-928-9565

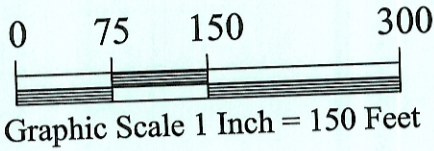

Property Location:

Situate in the Township of Canaan, County of Athens, State of Ohio, and being a part of Fraction #24 in the Southwest Quarter of Section 28, Township 5N, Range 13W, Ohio Company Purchase. Being a survey of a portion of an original 94.17 acre parcel (by deed) being currently conveyed to Elizabeth O. Markovich and Joseph E. Markovich, of record by Official Record 171, Page 397, in the record of deeds in the Athens County Recorders Office.


Prepared For:

Mr. Joe Markovich
 Athens, Ohio 45701

Bearings of this plat are based on the West line of the Southwest Quarter of Section 28 in Canaan Township as being N 03° 30' 00" E and is an assumed Meridian used to denote angles only.

Hocking Conservancy District
 Deed Vol. 330, Page 473
 (2.11 Ac +/-)

Hocking Conservancy District
 Deed Vol. 285, Page 504
 (3.88 Ac +/-)

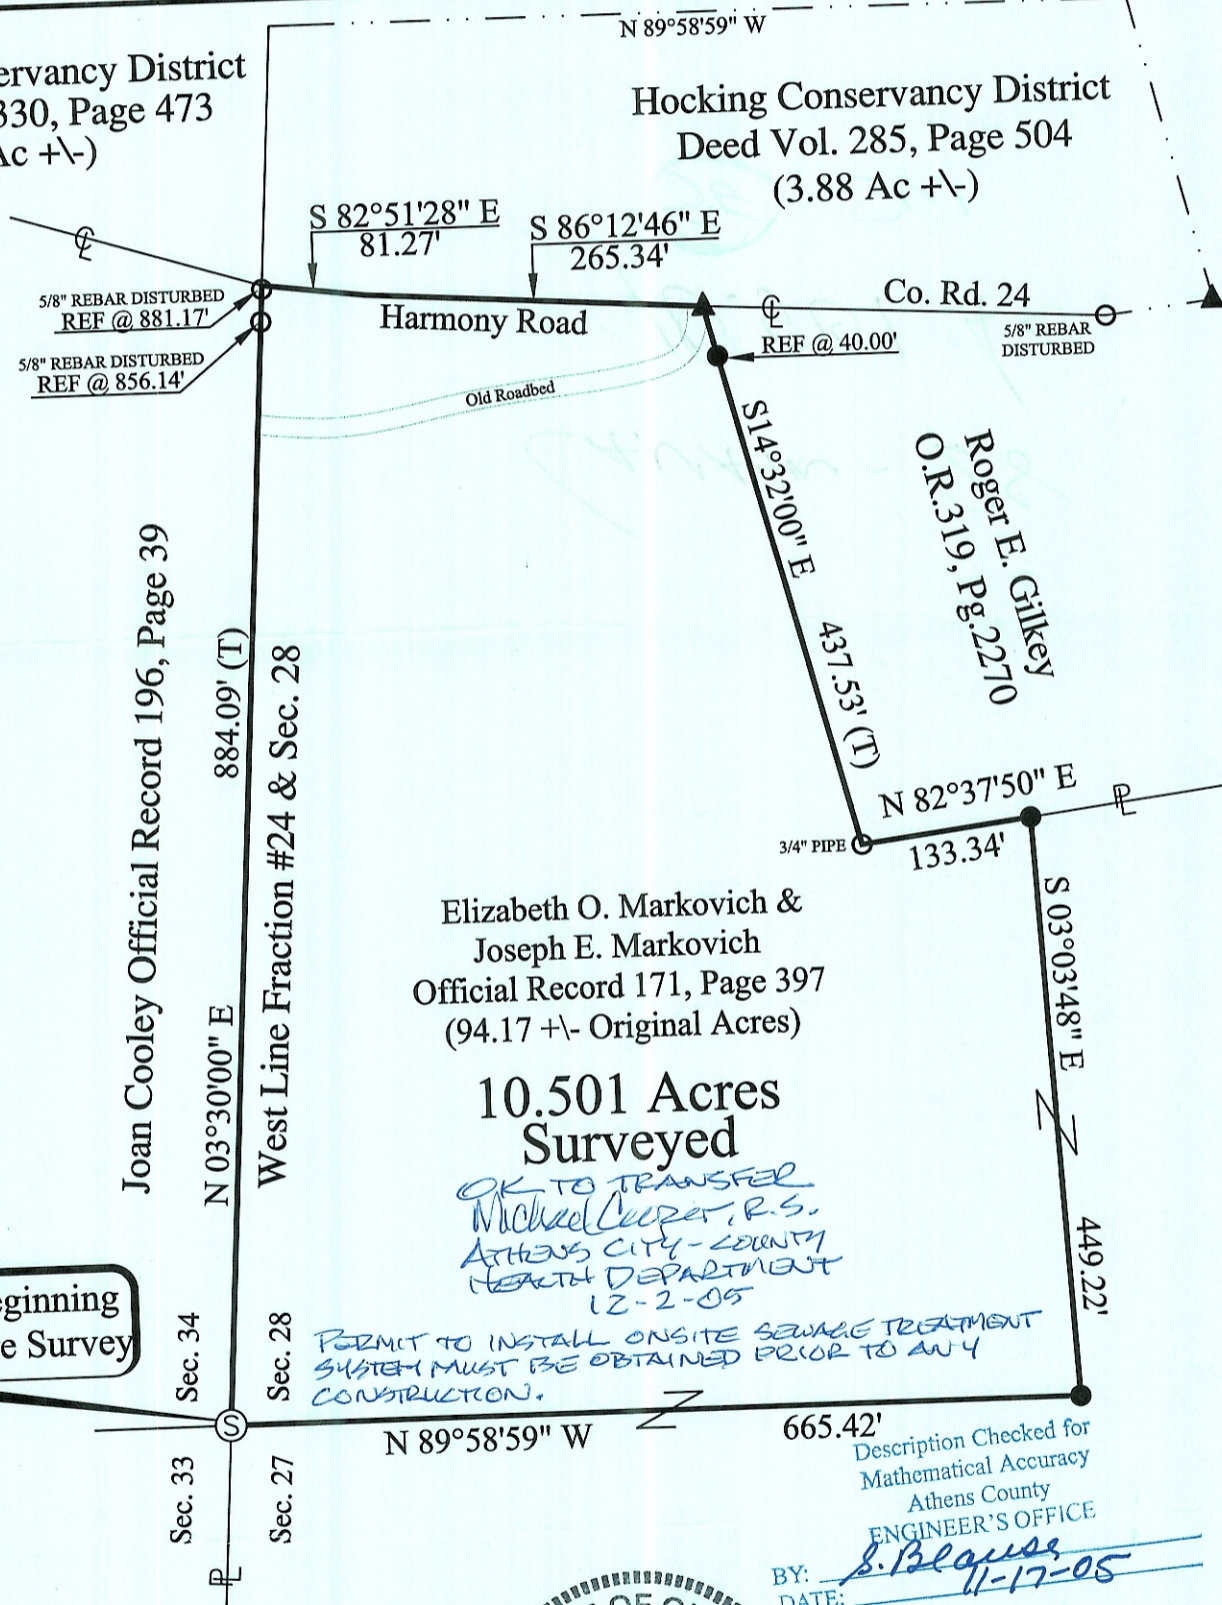

Elizabeth O. Markovich &
 Joseph E. Markovich
 Official Record 171, Page 397
 (94.17 +/- Original Acres)


**10.501 Acres
 Surveyed**

*OK TO TRANSFER
 Michael Cooper, P.S.
 ATHENS CITY-COUNTY
 HEALTH DEPARTMENT
 12-2-05*

*PERMIT TO INSTALL ONSITE SEWAGE TREATMENT
 SYSTEM MUST BE OBTAINED PRIOR TO ANY
 CONSTRUCTION.*

Description Checked for
 Mathematical Accuracy
 Athens County
 ENGINEER'S OFFICE

BY: *S. Blaine*
 DATE: *11-17-05*

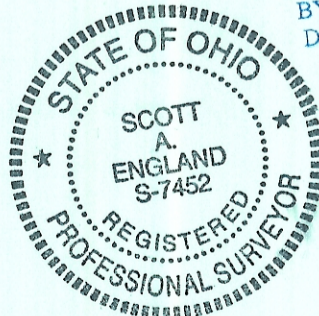

LEGEND

- - Iron Pin Found
 Size & Type as Noted
- - Iron Pin Set
 5/8" Rebar with a Red Cap
 Labeled S.A. England #7452
- ▲ - Rail Spike Found
- ⊙ - Stone Found wX
- (T) - Total Dimension

Place of Beginning
 10.501 Acre Survey

I Hereby Certify That An Actual Survey Of
 The Premises Was Made And That This Plat
 Is Correct To The Best Of My Knowledge.

Dated: *11/18/05*

[Signature]
 Scott A. England, P.S.
 Ohio Registered Surveyor #7452