

Section 2, Town 5, Range 13


SCALE, 20 RODS TO AN INCH.

50 scale  
FOR CHAINS  
5 CH. per inch

1" = 330'

Survey D

70  
37  
22  
1305

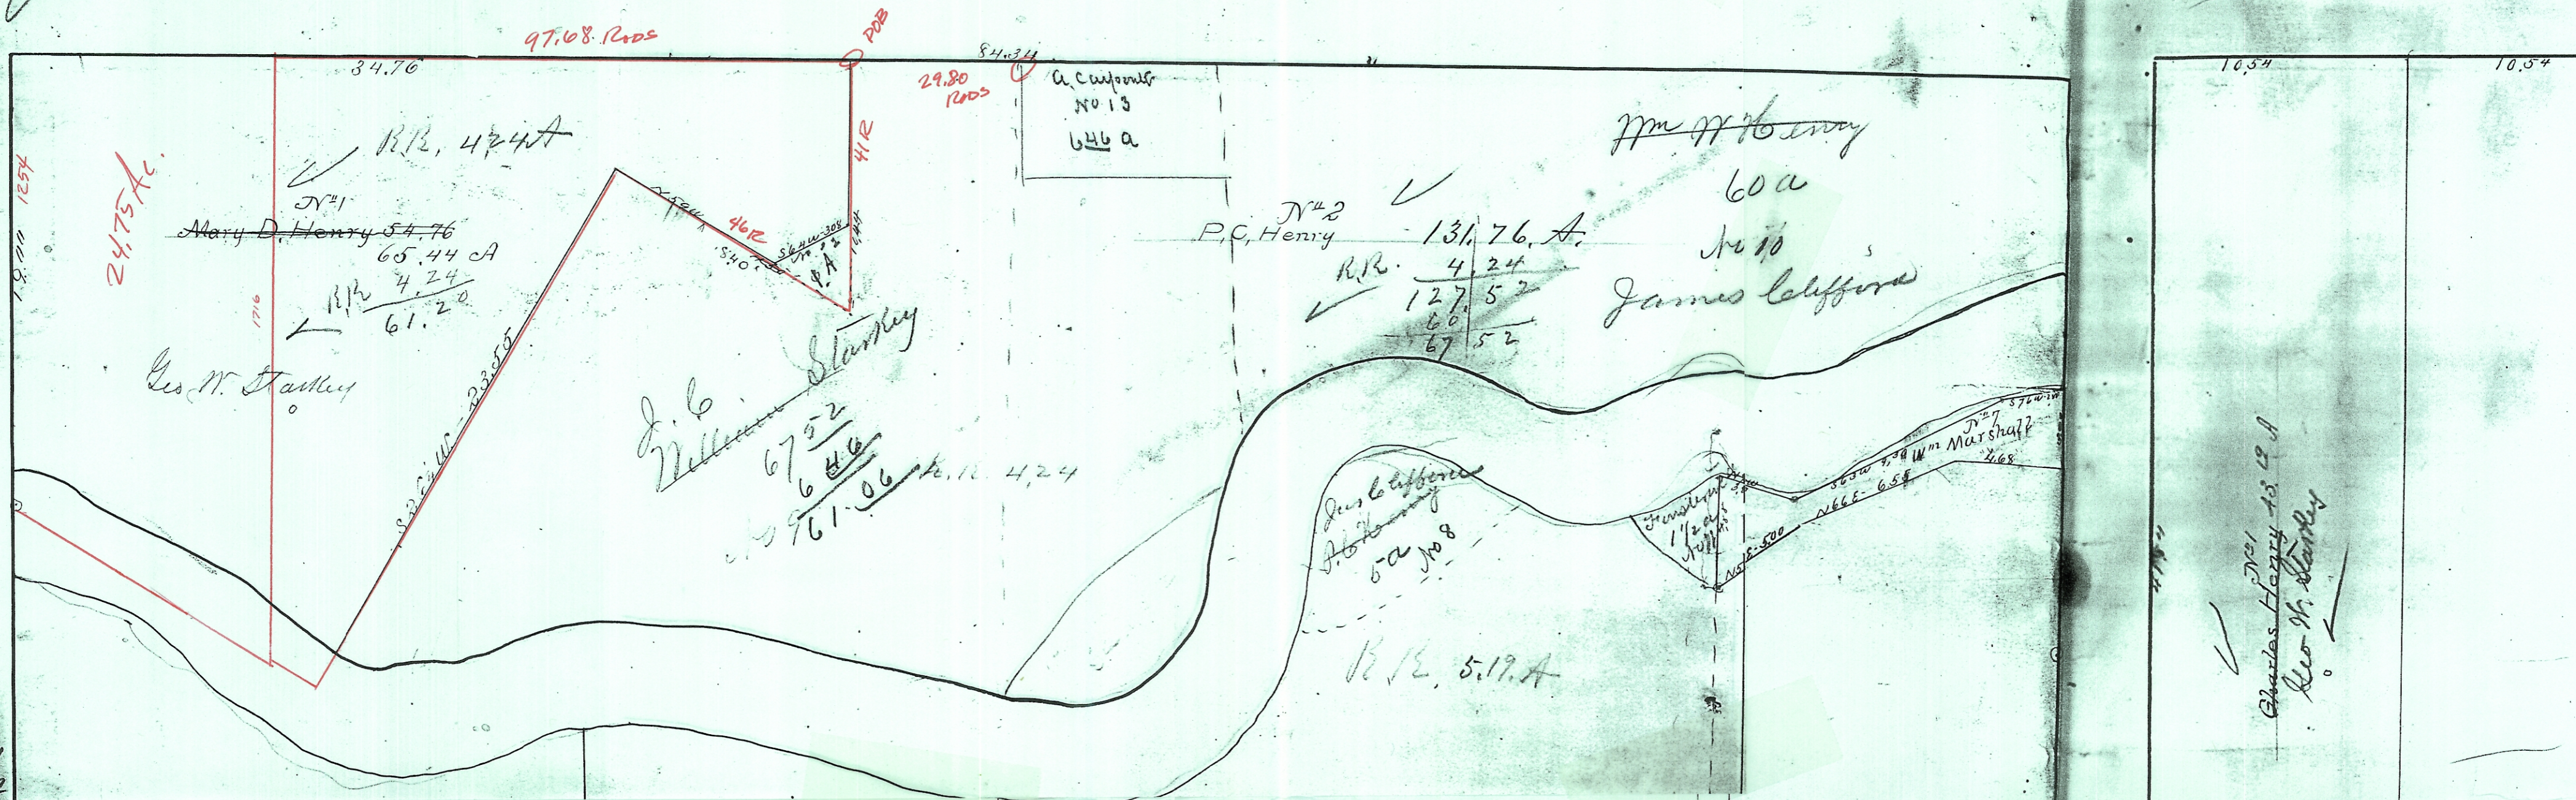

24.75 Ac.

97.08 Rods

29.80 Rods

Mary D. Henry 54.76  
65.44 CA  
4.24  
61.20

Geo. W. Stanley

67.52  
6.46  

A. Campbell  
No 13  
646 a

P. C. Henry 131.76 A.  
R.R. 4.24  
127.52  
60  
67.52



R.R. 5.19 A.

Wm Marshall  
2.68

Charles Henry 13.12 A  
Geo. W. Stanley

No 1  
2  
3  
4