


SOUTHEASTERN LAND SURVEYS

LEONARD F. SWOYER
REGISTERED LAND SURVEYOR

Box 208A
Route Five
Athens, Ohio 45701
614/593-8701

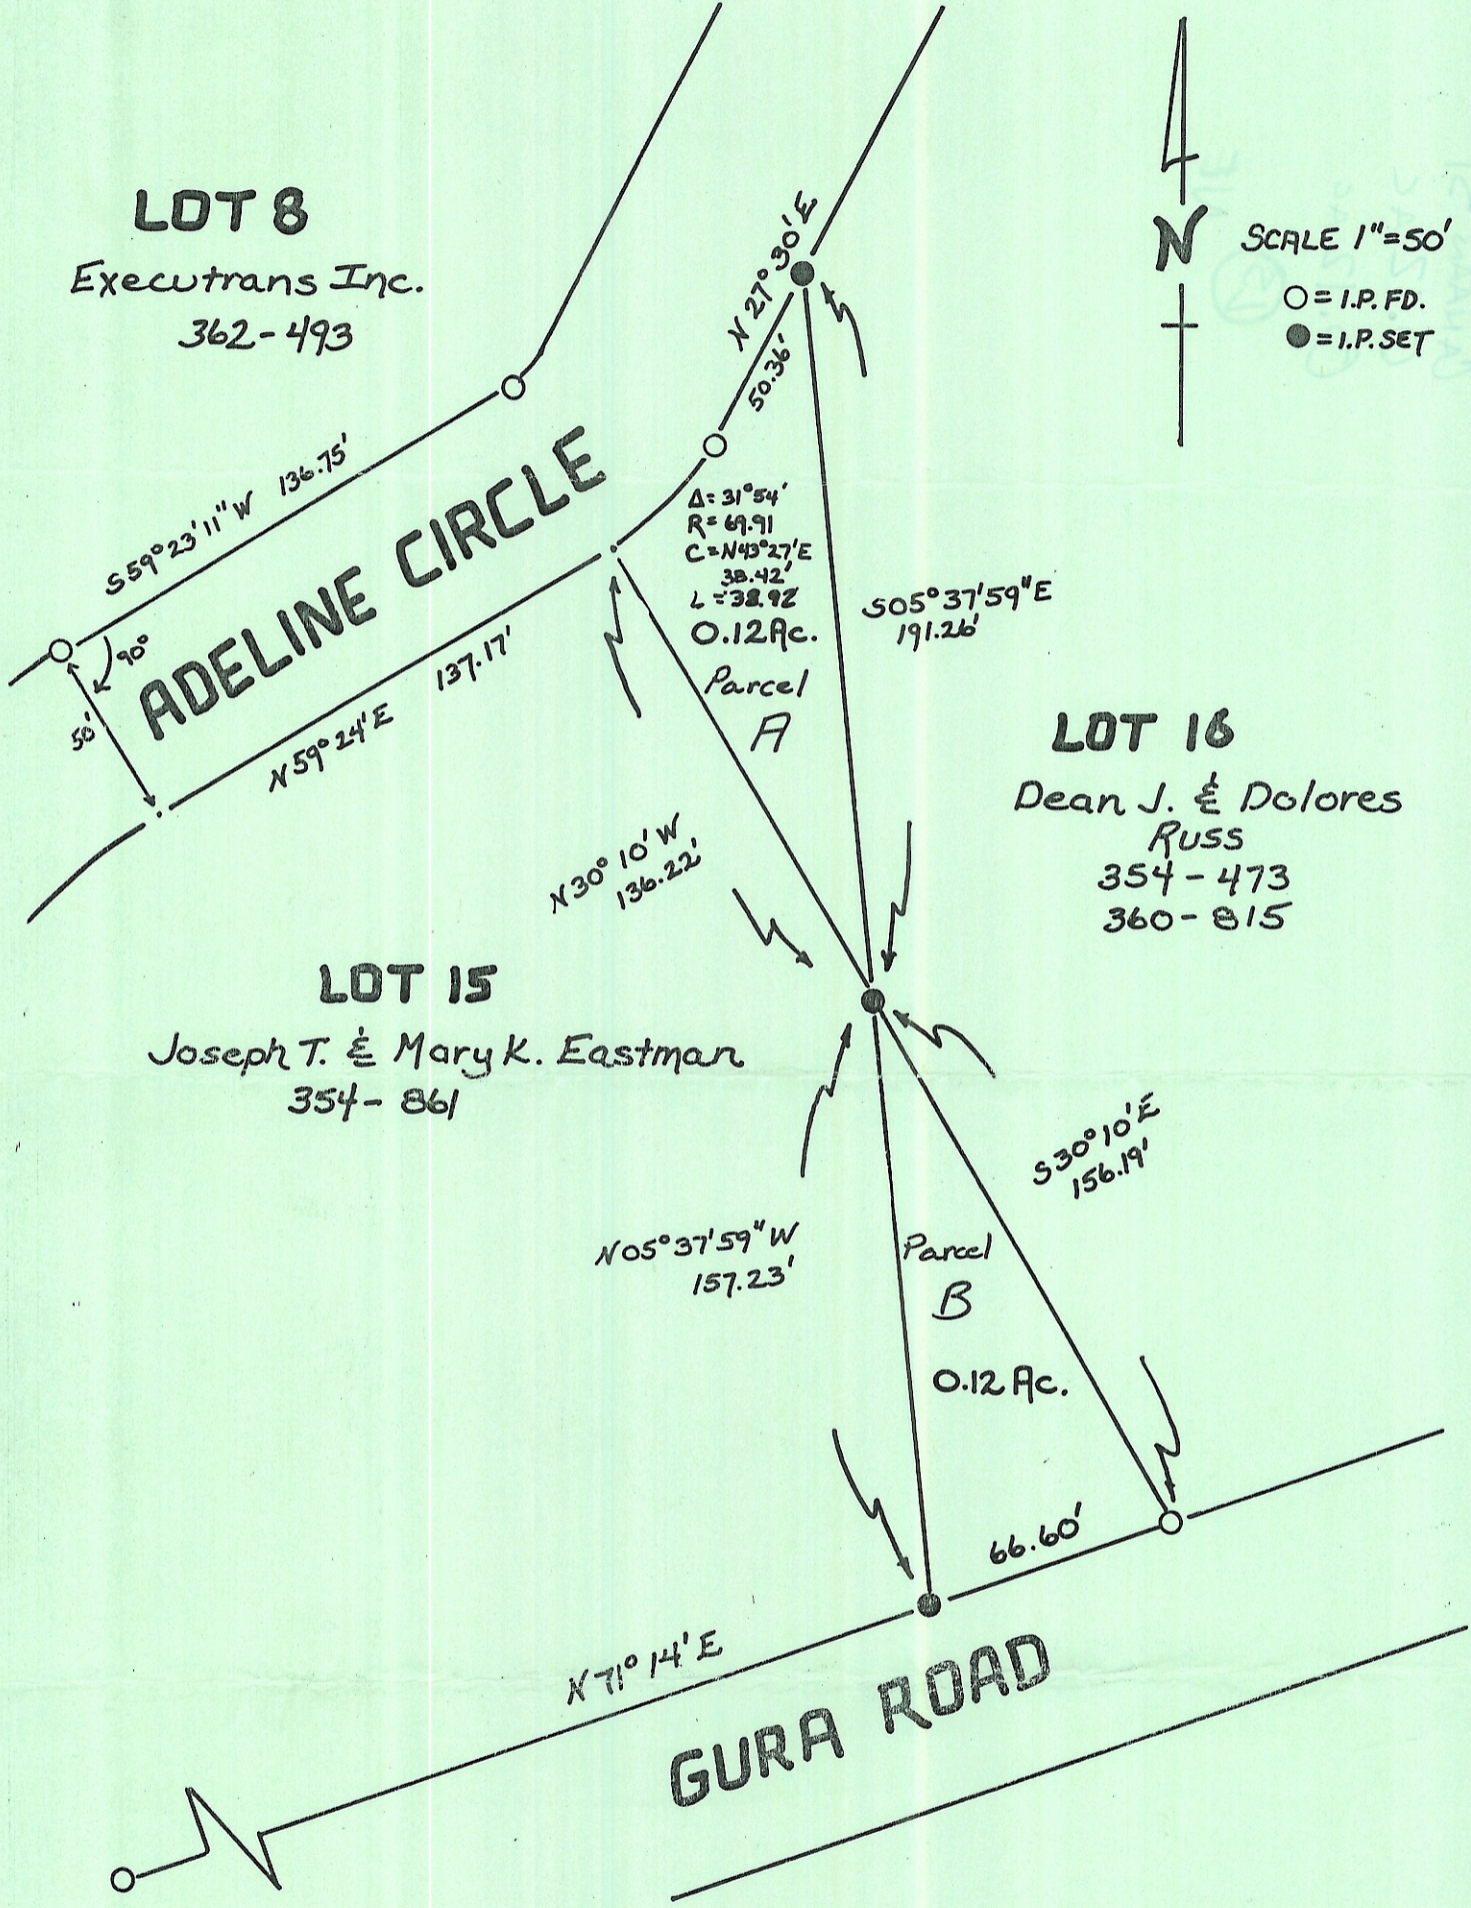

LOT 8

Executrans Inc.
362-493

ADELINE CIRCLE

LOT 15

Joseph T. & Mary K. Eastman
354-861

LOT 16

Dean J. & Dolores
Russ
354-473
360-815

GURA ROAD

Plat of TWO - 0.12 Acre Tracts Scale 1" = 50'
 Surveyed for Mr. Joe Eastman Date 9/10/87
 Subdivision Hickory Hills Subdiv., N.E. 1/4 Sec. 31
 Township Canaan Section 31 Town 5 Range 13
 Corporation ---- County Athens State Ohio
Leonard F. Swoyer II
 Leonard F. Swoyer II Reg. Prof. Land Surveyor No. 6765