
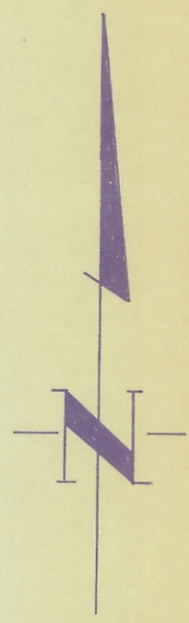


Sec 34  
Canaan

AM  
4.29 Acre  
Sec 34 SE

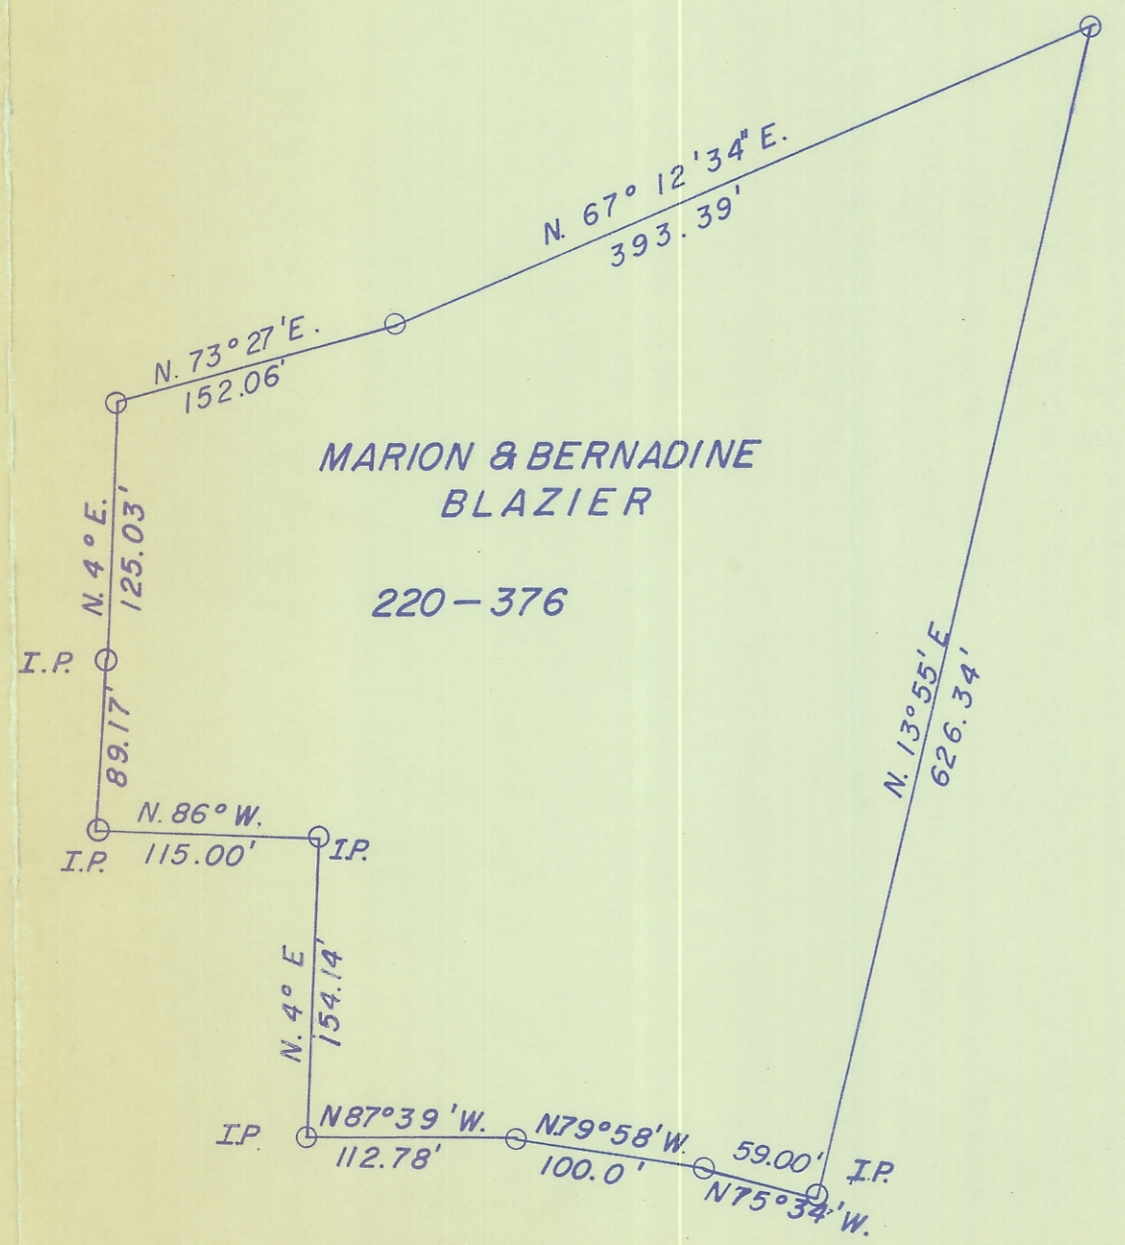

### SURVEY OF 4.29 ACRE TRACT

Located in Section 34,  
Township 5 North, Range 13 West  
Ohio River Survey,  
Canaan Township, Athens County, Ohio  
For  
HOCKING CONSERVANCY DISTRICT

Surveyed & Platted  
By  
EVANS, MECHWART, HAMBLETON & TILTON, INC.  
Consulting Engineers & Surveyors  
Athens, Ohio

By George A. Maus  
Registered Surveyor No. 5508

Scale 1"=100'

Oct 1968