John Lucas Survey

Description of 0.9611

Situated in Section 36, Town 5, Range 12, Carthage Township, Athens County, Ohio and being more particularly described as follows;

Commencing at the northeast corner of said Section 36; thence along the east line of said section S 6°17'25" W 1779.53 feet to a railroad spike found in the center of County Road 24 (South Canaan Road), the point of beginning of the tract herein described; thence continuing S 6°17'25" W 169.21 feet to an iron pin set (passing an iron pin found at 139.69 feet; thence leaving the section line N 85°54'40" W 188.25 feet to an iron pin found; thence S 59°37'45" W 81.41 feet to an iron pin set; thence N 00°34" 59" E 180.38 feet to the center of County Road 24 (passing iron pins found at 39.77 feet and at 159.05 feet); thence along the centerline of said road N 86°45'32" E 275.15 feet to the point of beginning containing 0.9611 acres.

Prior deed reference Volume 206, Page 357 Athens County Deed Records.

Gregory K. Wright

S-6535

17498 South Canaan Road

Athens, Ohio 45701


Description checked for Mathematical Accuracy

ATHENS COUNT

DATE/

8-8-90

Remainder to be held jointly by John Rucas and Harry and Shirly Kennedy

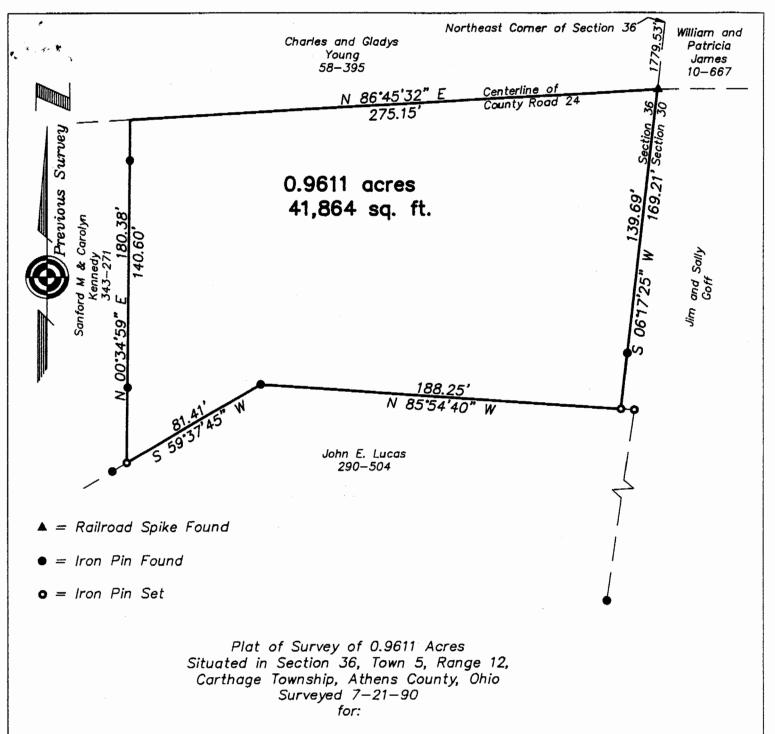

John Lucas

