




SOUTHEASTERN LAND SURVEYS

LEONARD F. SWOYER
REGISTERED PROFESSIONAL LAND SURVEYOR

3428 Pleasant Hill Road
Athens, Ohio 45701
614/593-8701

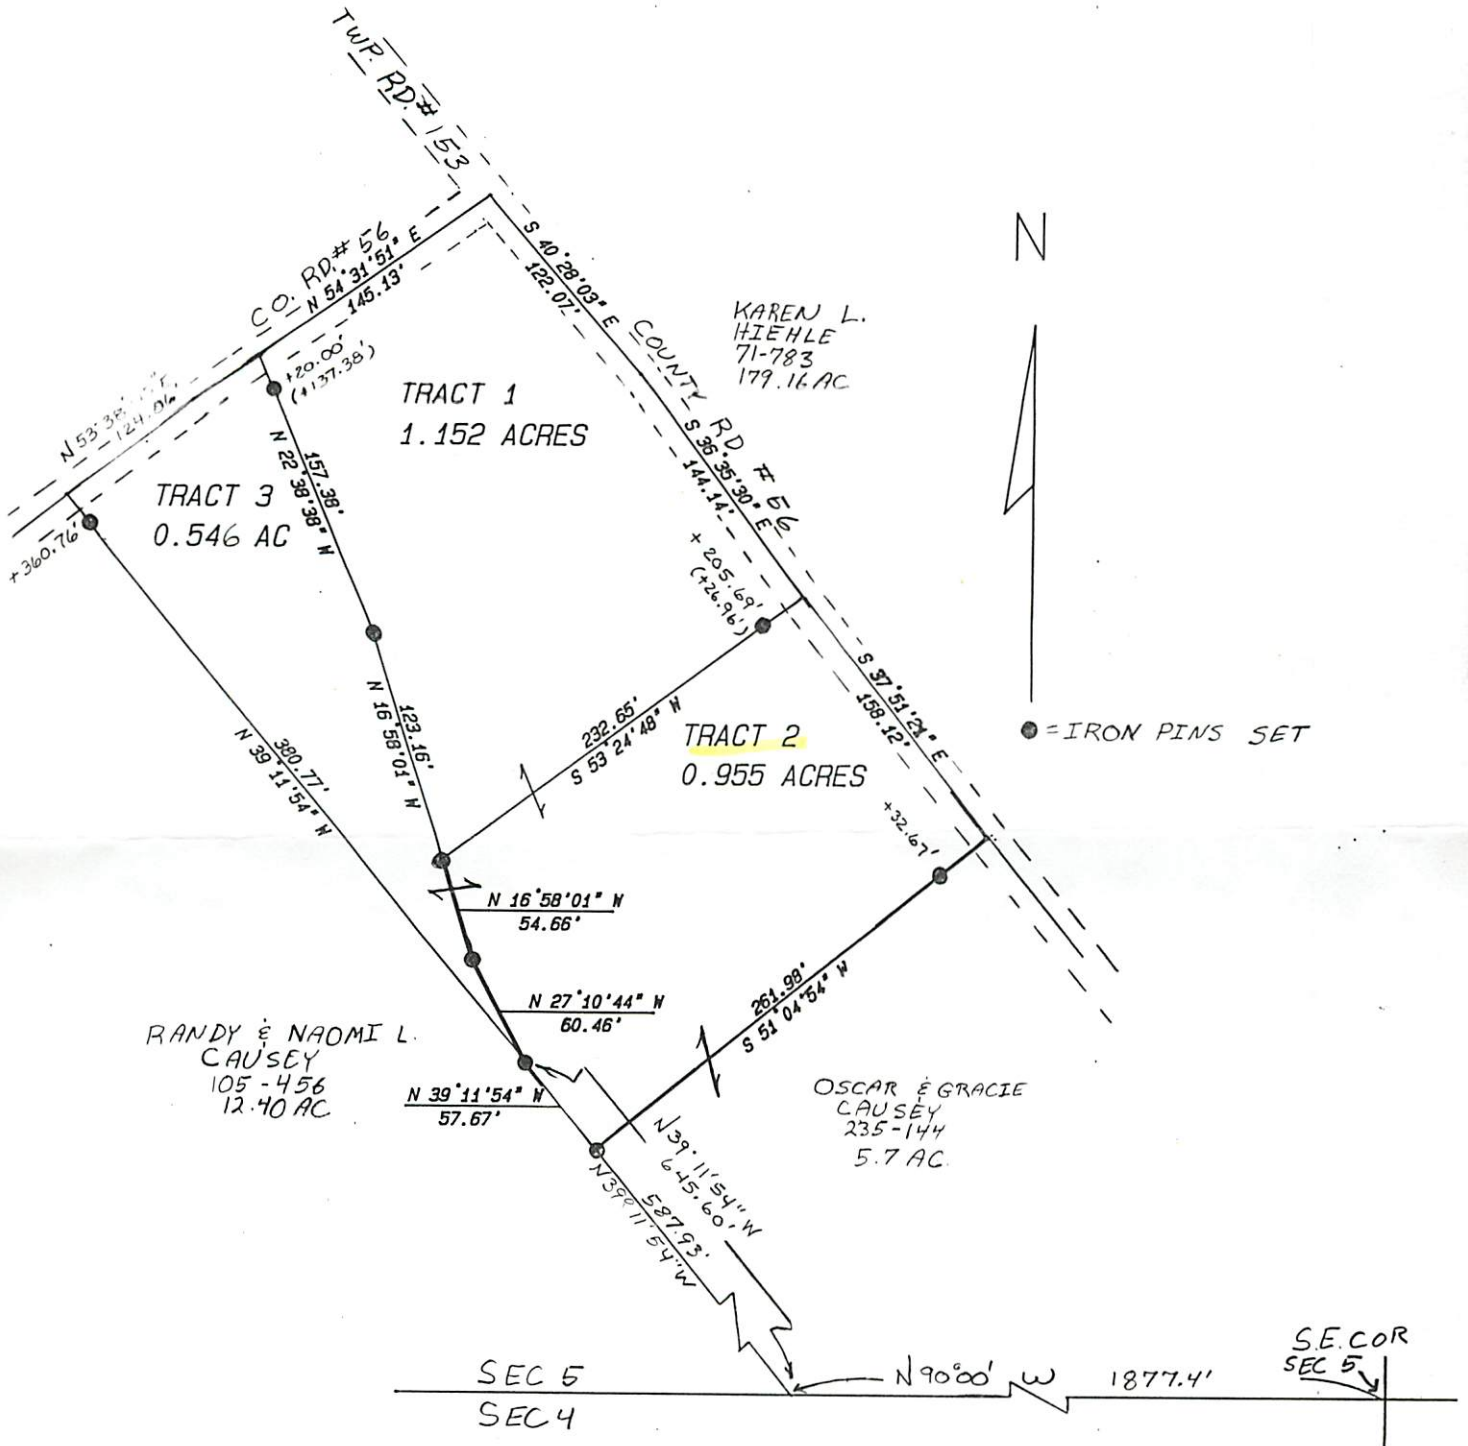

Plat of 1.152, 0.955, 0.546 Acre Tract Scale 1"=100

Surveyed for Oscar Causey Date 8/30/93

Subdivision ---

Township Carthage Section 5 Town 5 Range 12

Corporation --- County Athens State Ohio

Leonard F. Swoyer Jr.
Leonard F. Swoyer Jr. Reg. Prof. Land Surveyor No. 6765

