



331-123

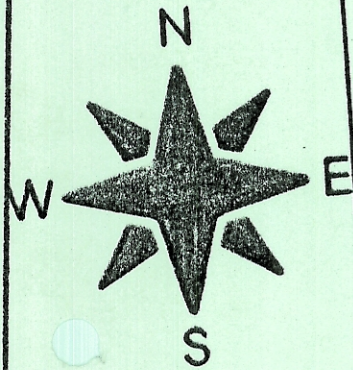

Scale 1" = 50'

- IRON PINS FOUND
- IRON PIPES SET

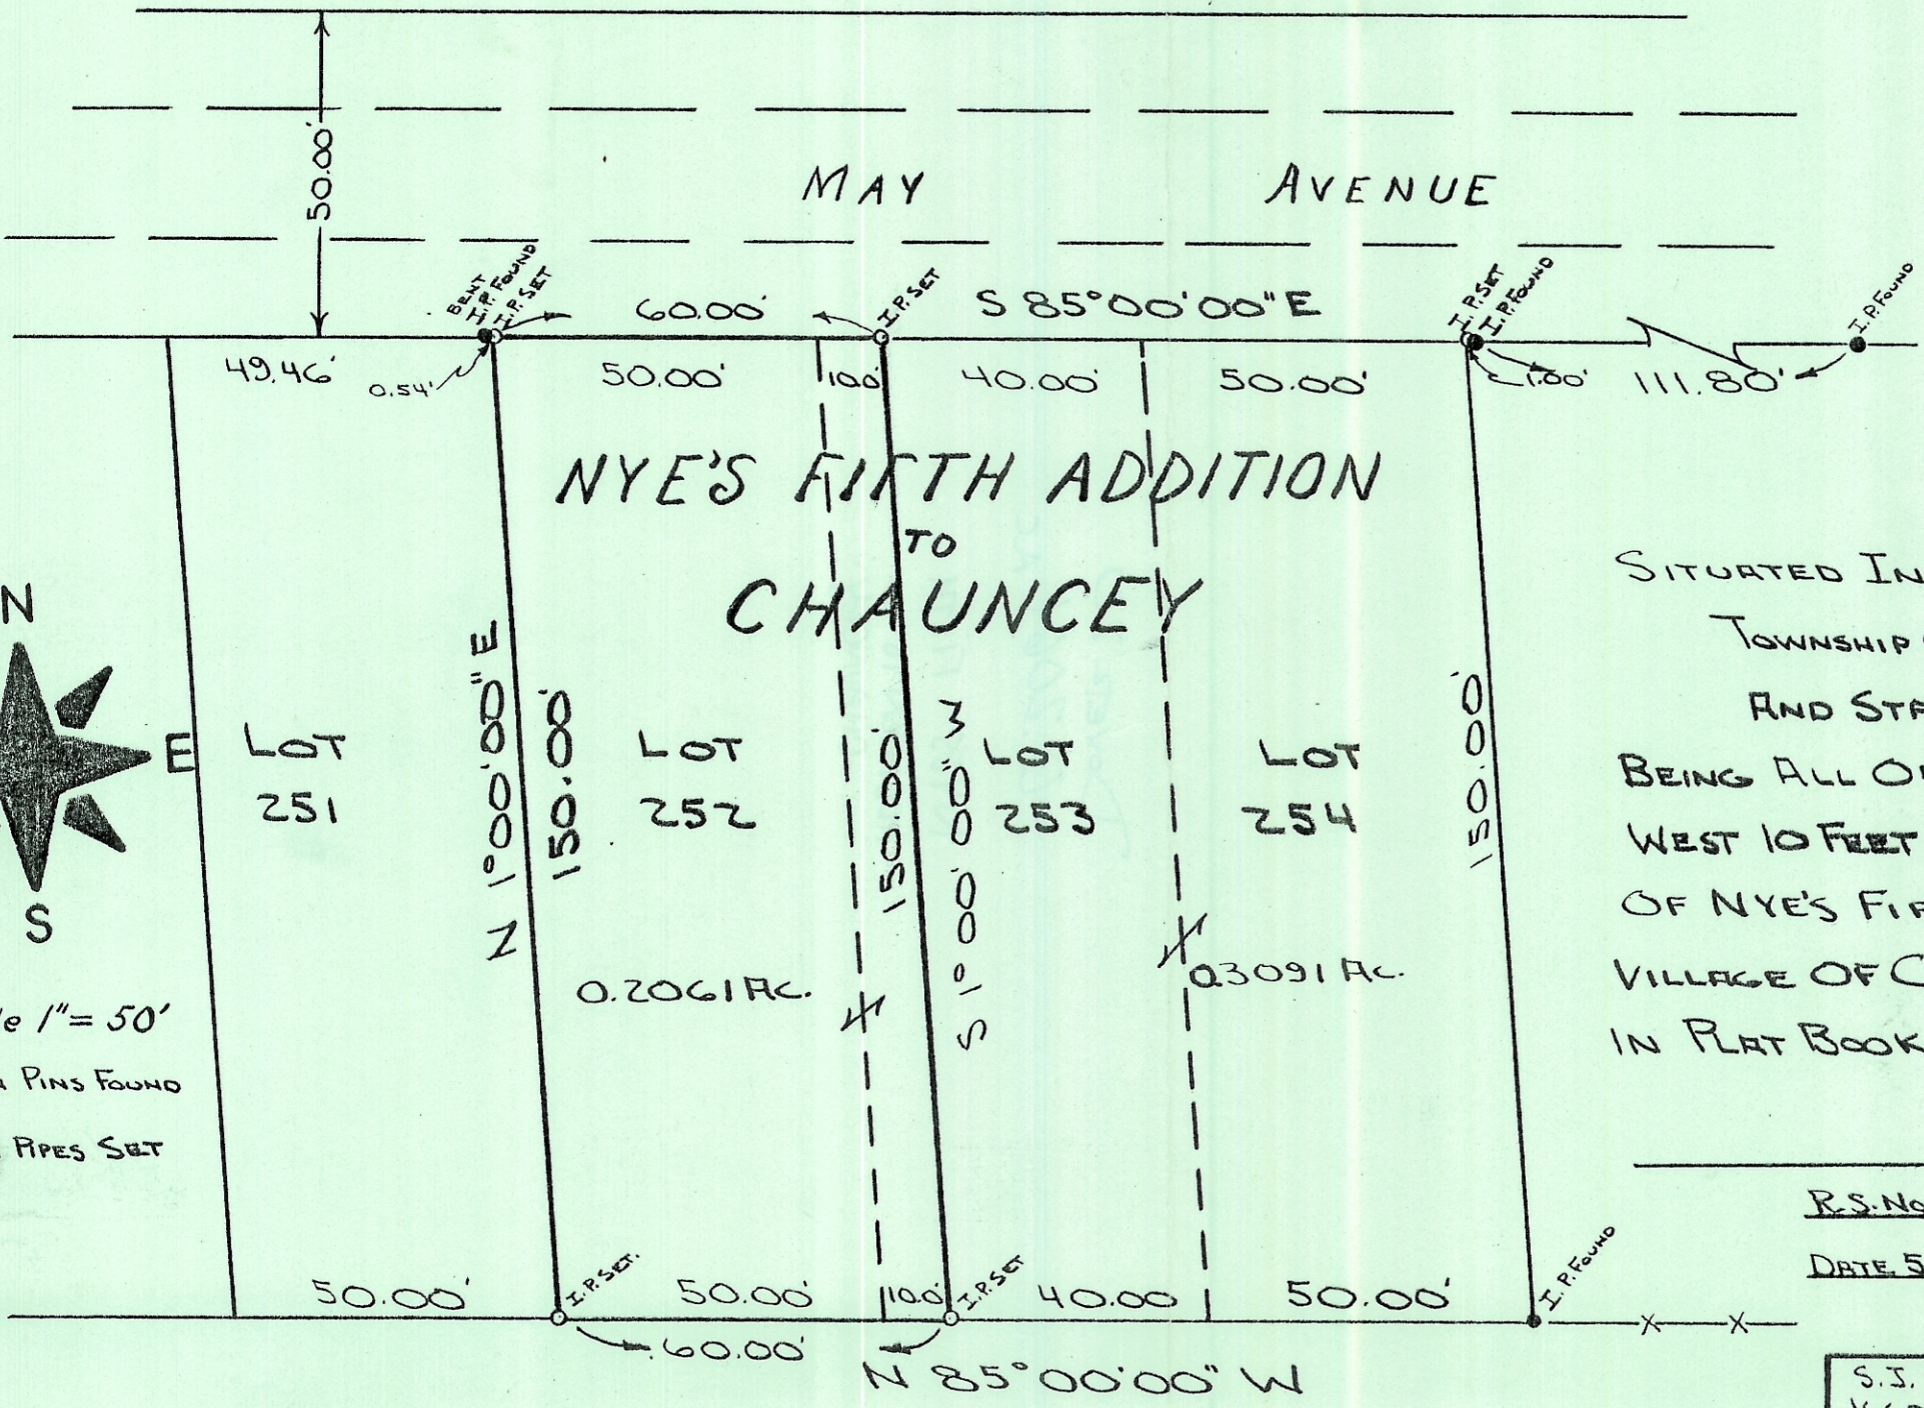

PLAT OF SURVEY
FOR

WILLIAM H. SNODGRASS
0.2061 ACRE TRACT

SITUATED IN THE VILLAGE OF CHAUNCEY
TOWNSHIP OF DOVER, COUNTY OF ATHENS
AND STATE OF OHIO

BEING ALL OF LOT No. 252 AND THE
WEST 10 FEET OF LOT No. 253
OF NYE'S FIFTH ADDITION TO THE
VILLAGE OF CHAUNCEY AS RECORDED
IN PLAT BOOK No. 5 Pg. No. 85

RS. No.

DATE 5-5-1981

S. J. SCHLOSS
166 LINCOLN HTS.
POMEROY, OHIO 43163
(614-992-5977)