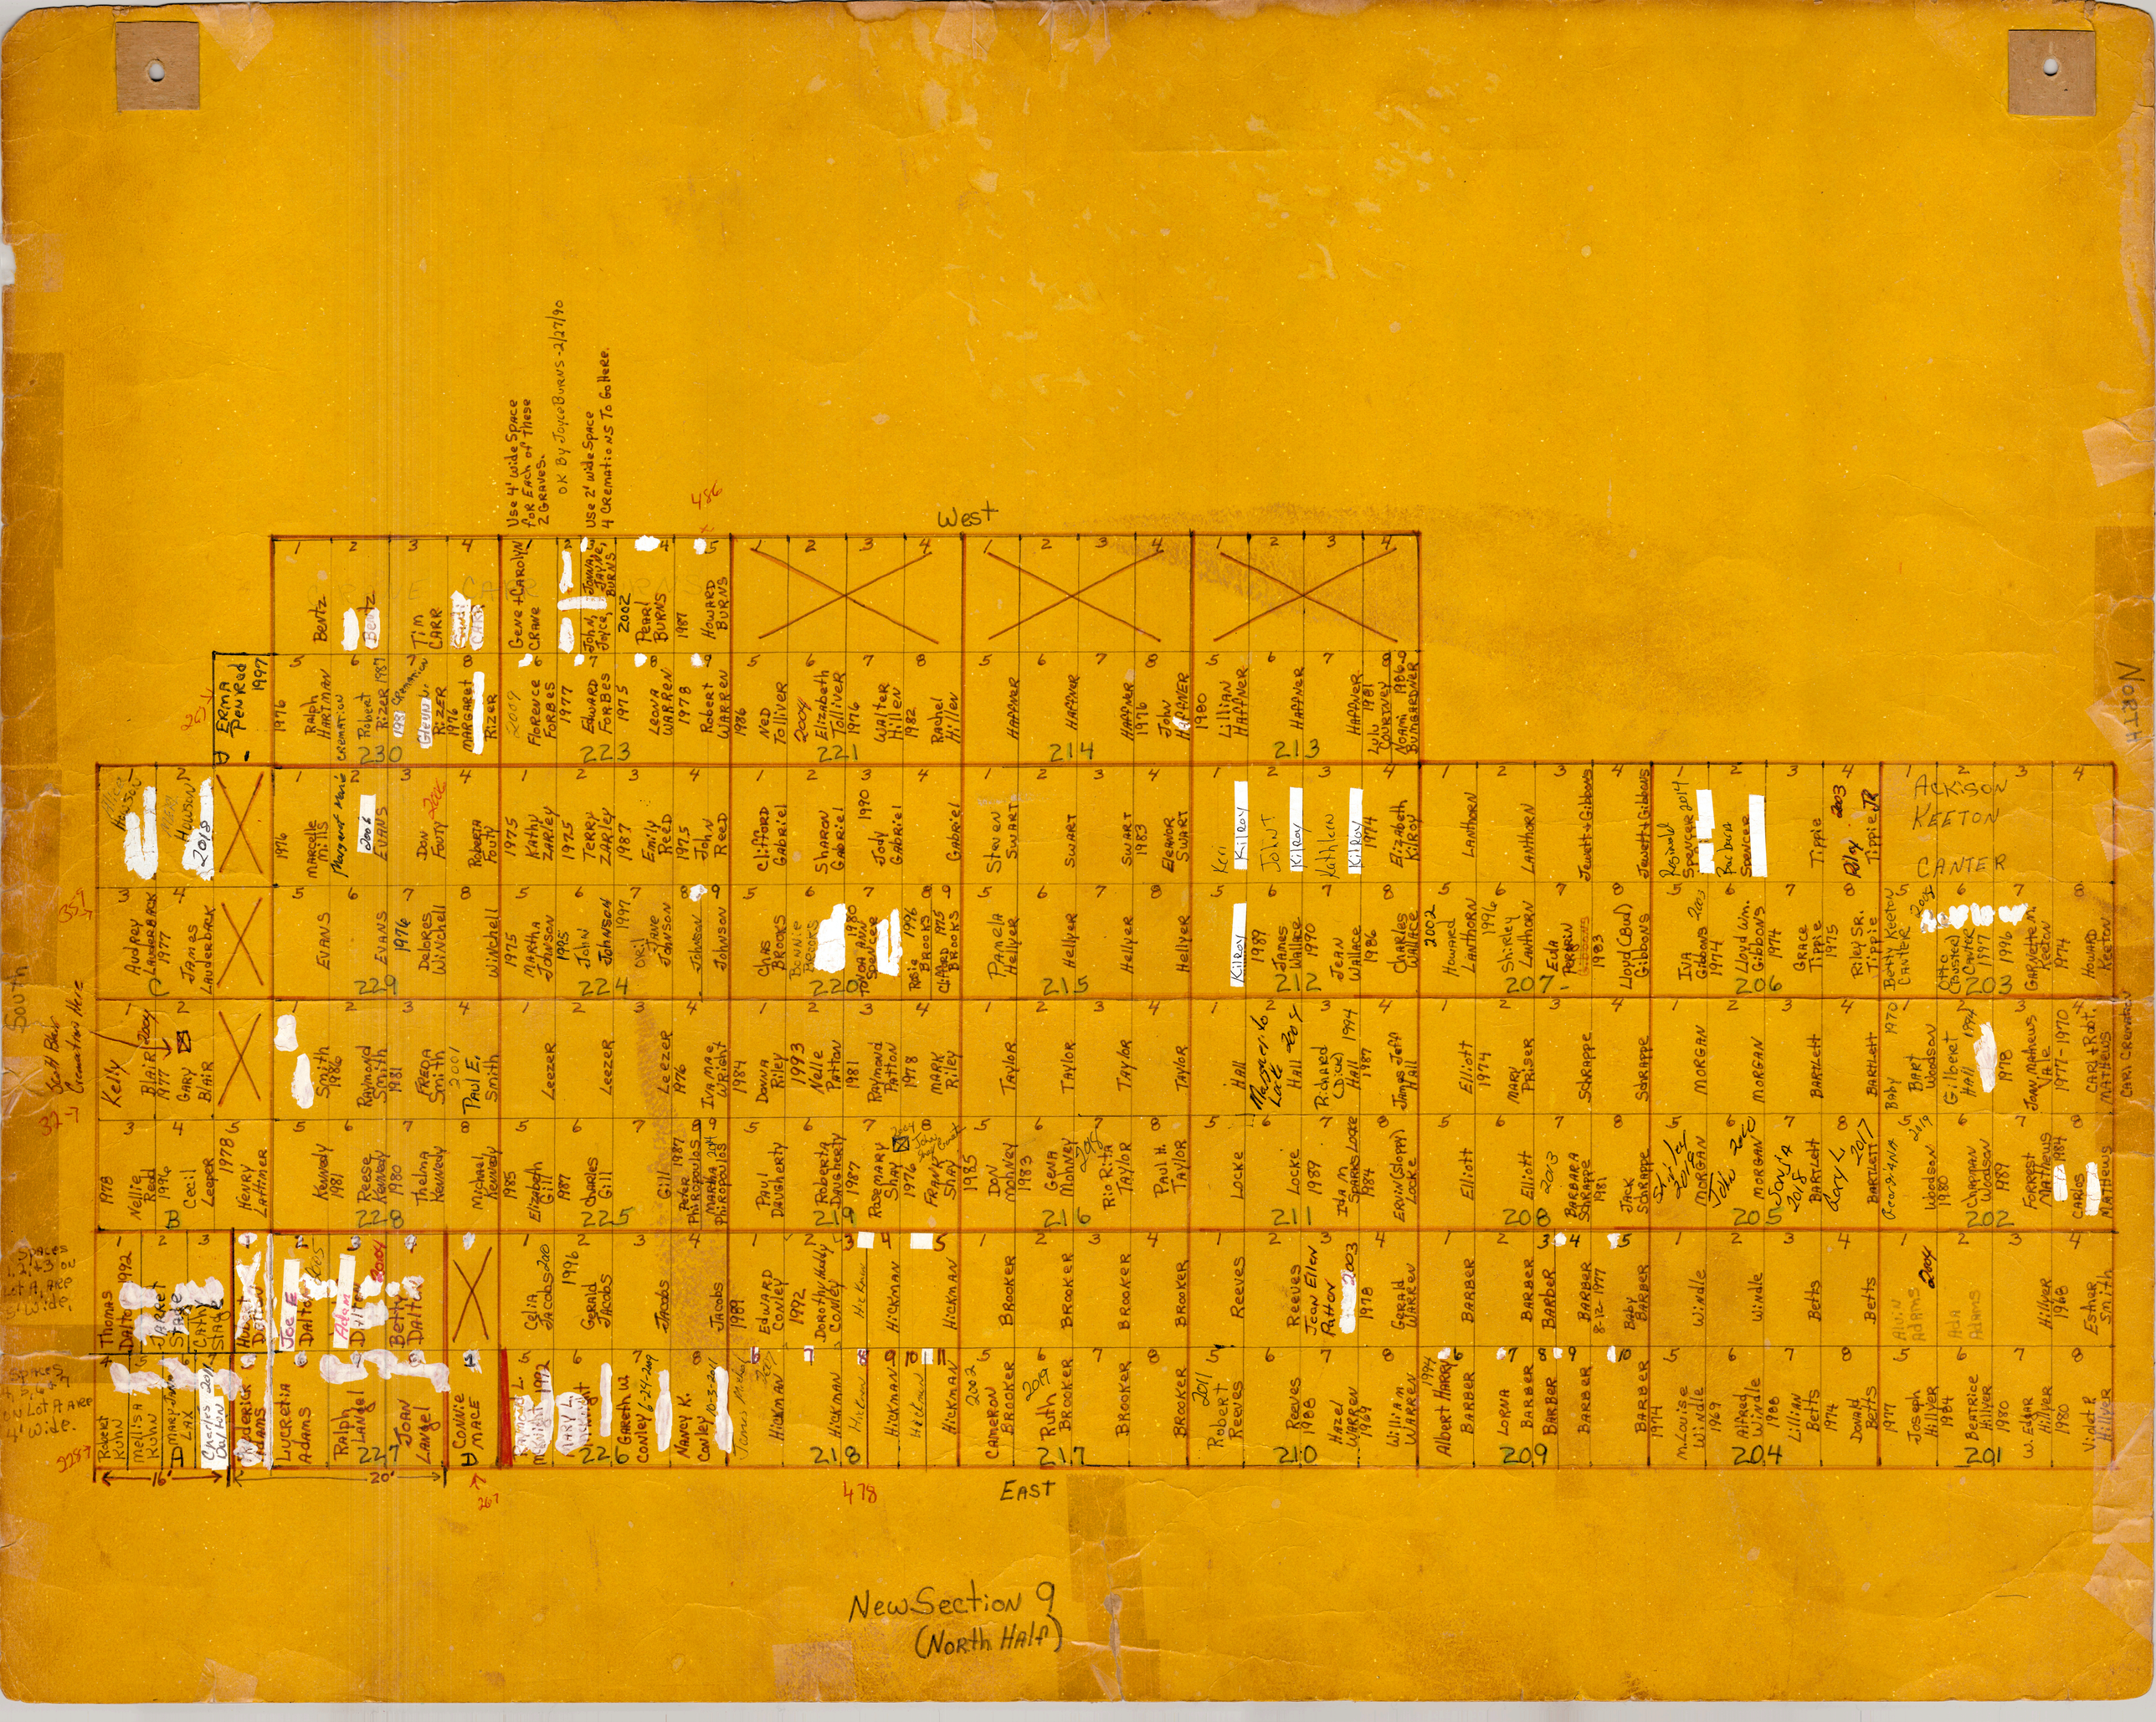
West
East
South
North
Use 4' wide Space for Each of These 2 Graves.
OK By Joyce Burns - 2/27/90
Use 2' wide Space 4 Cremations To Go Here.
Spaces 1, 2, & 3 on Lot A are 5' wide.
Spaces 4, 5, 6 & 7 on Lot A are 4' wide.
16'
20'
478
486
Erma Penrod 1997
Bentz
Tim Carr
Gene + Carolyn Crane
Johnny, Joyce, Jayne, Burns
2002 Pearl Burns
1987 Howard Burns
Ralph Hartman
Robert Rizer 1987
Glenn W. Rizer 1976
Margaret Rizer
Florence Forbes
Edward Forbes 1975
Leona Warren 1978
Robert Warren 1986
Ned Tolliver
Elizabeth Tolliver 1976
Walter Hillen 1982
Rachel Hillen
Haffner
John Haffner 1980
Lillian Haffner
Lulu Courtney 1981
Noami Bumgardner 1986
Marcelle Mills
Margaret Marie
Evans
Don Fouty 2006
Roberta Fouty
Kathy Zarley 1975
Terry Zarley 1987
Emily Reed 1975
John Reed
Clifford Gabriel
Sharon Gabriel
Jody Gabriel 1990
Gabriel
Steven Swart
Swart 1983
Eleanor Swart
Keri Kilroy
John T. Kilroy
Kathleen Kilroy 1974
Elizabeth Kilroy
Lanthorn
Jewett + Gibbons
Rosinold Spencer 2014
Barbara Spencer
Tippie
Riley Tippie JR 2003
Ackison
Keeton
Canter
Audrey Lauderback 1977
James Lauderback
Evans
Delores Winchell
Winchell
Martha Johnson 1975
John Johnson 1997
Oril Jane Johnson
Johnson
Chas Brooks
Bonnie Brooks
Tonya Ann Spencer 1980
Rosie Brooks 1996
Clifford Brooks 1975
Pamela Hellyer
Hellyer
Kilroy 1989
James Wallace 1990
Jean Wallace 1986
Charles Wallace
Howard Lanthorn 2002
Shirley Lanthorn 1996
Eula Perrin
Lloyd (Bud) Gibbons
Iva Gibbons 1974
Lloyd Wm. Gibbons 1974
Grace Tippie 1975
Riley Sr. Tippie
Betty Keeton Canter 2004
Otto (Tousted) Canter 1997
Garnette M. Keeton 1974
Howard Keeton
Kelly
Blair 1977
Gary Blair
Smith 1986
Raymond Smith 1981
Freda Smith
Paul E. Smith 2001
Leezer
Ivamae Wright 1984
Donna Riley 1993
Nelle Patton 1981
Raymond Patton 1978
Mark Riley
Taylor
Hall
Margaret Lake 2004
Richard (Dick) Hall 1994
James Jeff Hall 1987
Elliott 1974
Mary Priser
Schrappe
Morgan
Bartlett
Baby 1970
Bart Woodson
Gilbert Hall 1994
Joan Mathews Vale 1977-1970
Carl + Robt. Mathews
Carl Cremation
Nellie Redd 1996
Cecil Leeper 1978
Henry Lattimer
Kennedy 1981
Reese Kennedy 1980
Thelma Kennedy
Michael Kennedy 1985
Elizabeth Gill 1987
Charles Gill
Gill 1987
Peter Phiropoulos
Martha Phiropoulos
Paul Daugherty
Roberta Daugherty 1987
Rosemary Shay 1976
Frank Shay
Don Mohney 1983
Gena Mohney
Rio Rita Taylor
Paul H. Taylor
Locke
Ida M. Sparks Locke 1984
Ervin (Sloppy) Locke
Elliott
Barbara Schrappe 1981
Jack Schrappe
Shirley 2019
Morgan
John 2010
Sonja 2018
Bartlett
Gary L. 2017
Georgiana 2019
Woodson 1980
Chapman Woodson 1989
Forrest Mathews 1984
Carlos Mathews
Thomas Dalton 1992
Jarret Stage
Cathy Stage
Robert Dalton
Joe E. Dalton
Adam Dalton
Betty Dalton
Celia Jacobs 2000
Gerald Jacobs 1996
Jacobs
Jacobs
Edward Conley 1992
Dorothy Haddy Conley
Hickman
Brooker
Reeves
Jean Ellen Patton 2003
Gerald Warren 1978
Barber
Barber 8-12-1977
Baby Barber
Windle
Betts
Alvin Adams 2004
Ada Adams
Hillyer 1968
Esther Smith
Robert Kuhn
Mellisa Kuhn
Mary Jane Lax
Charles Dalton
Frederick Adams
Lucretia Adams
Ralph Langel
Joan Langel
Connie Mace
Raymond L. Mcknight 1992
Mary L. Mcknight
Gareth W. Conley 6-24-2009
Nancy K. Conley 10-3-2011
James Michael
Hickman
Cameron Brooker 2002
Ruth Brooker 2019
Robert Reeves 2011
Reeves 1988
Hazel Warren 1969
William Warren
Albert Harry 1994
Lorna Barber
M. Louise Windle 1969
Alfred Windle 1988
Lillian Betts 1974
Donald Betts
Joseph Hillyer 1984
Beatrice Hillyer 1980
W. Edgar Hillyer 1980
Violet P. Hillyer
New Section 9
(North Half)