

McLEAN
224467

N 88°42'30"W
455.40'

*Sec. 14
Dover*

5.282 AC
0.250 AC
22.453 AC

SCALE 1"=200'
⊙=IRON PIN SET

SURVEY OF A 5.282 ACRE TRACT
A 0.250-ACRE TRACT AND A
22.453 ACRE TRACT IN
FRACTION I & FRACTION II
IN SECTIONS 14 & 15 T.10
R.14 DOVER TOWNSHIP ATHENS
COUNTY OHIO

SURVEYED AUG 84

John M. Branner
JOHN M. BRANNER
REG LAND SURVEYOR 6805


SEC 15
SEC. 14

25.587 AC
RESIDUAL

22.453 AC
SURVEY

SUMMERS
69.23 ac.
283/109

252/231

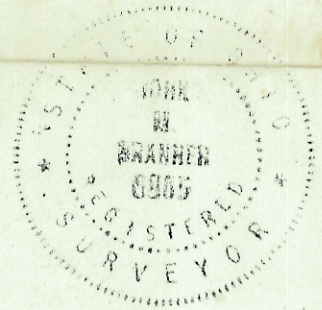

5.77 AC
RESIDUAL

SHIELDS
357/515
6.02 ac

333.07'
N 88°42'30"W

FRACTION II
FRACTION I

0.250 AC
SURVEY

5.282 AC
SURVEY

9.498 AC
RESIDUAL

SURVEY DATA	
A	N 88°42'29"W - 1190.42'
B	S 42°07'33"W - 1462.6'
C	S 26°28'46"W - 2489.4'
D	S 27°13'39"W - 230.93'
E	S 37°59'52"W - 58.62'
F	N 43°36'37"W - 314.75'
G	N 22°54'29"W - 403.07'
H	S 22°52'00"E - 43.22'
I	S 62°40'08"E - 159.28'
J	N 01°32'06"E - 109.35'
K	N 88°42'27"W - 161.26'
L	N 62°39'13"W - 135.89'
M	S 88°42'30"E - 725.03'

STONE NE COR. FR-1

T-324

T 323.4