




SCALE 1 INCH = 100 FEET

O = IRON PIN SET
Δ R.R.S. SET

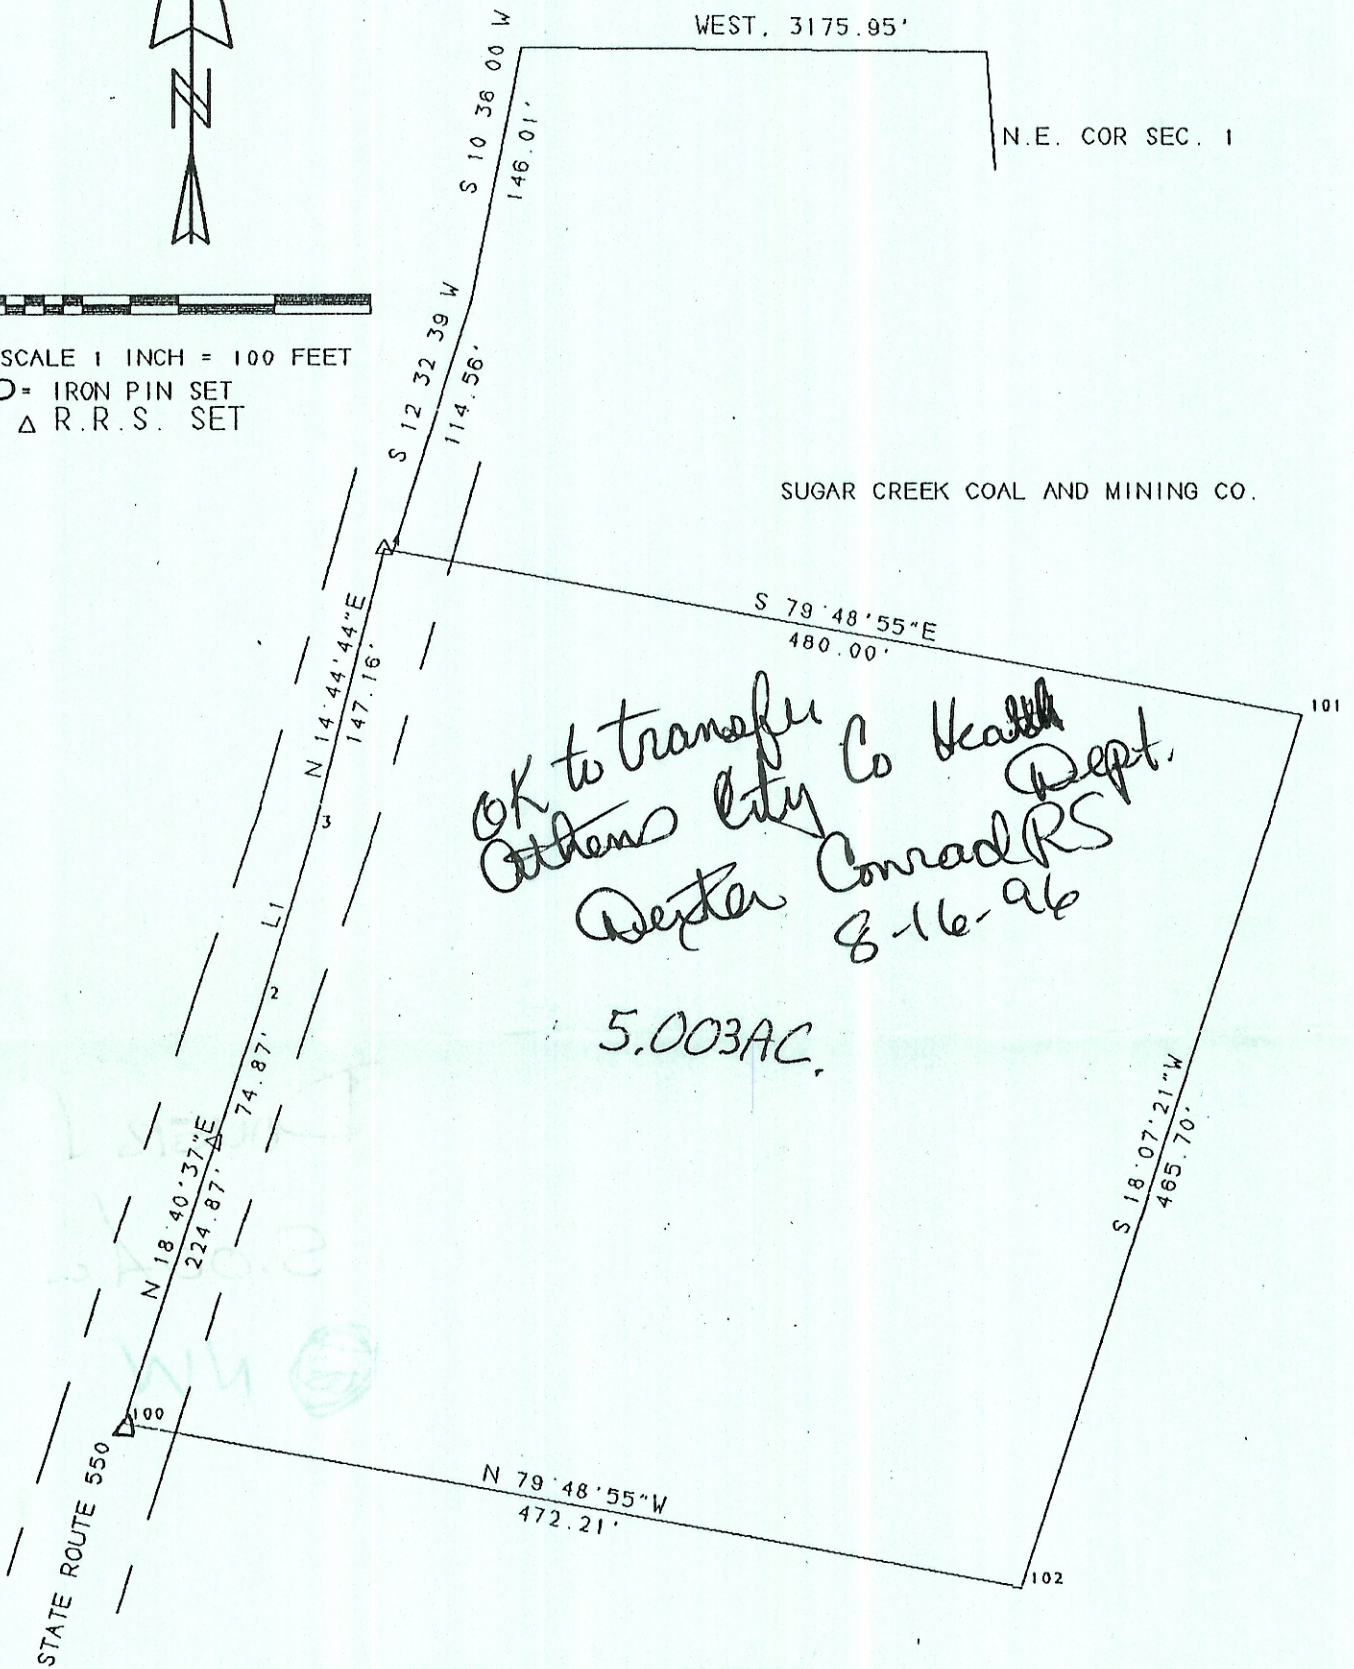

*OK to transfer
Athens City Co Health
Dept.
Dexter Conrad RS
8-16-96*

5.003AC.

LINE	BEARING	DISTANCE
L 1	N 17° 21' 55" E	92.87'

SURVEY OF A 5.003 ACRE TRACT IN SECTION 1
T. 10, R. 14, DOVER TOWNSHIP, ATHENS CO., O.
SURVEYED NOV. 1995

John M. Branner
JOHN M. BRANNER P.S., 6805
12500 N. PEACH RIDGE ROAD
ATHENS, OHIO 592-5778

