

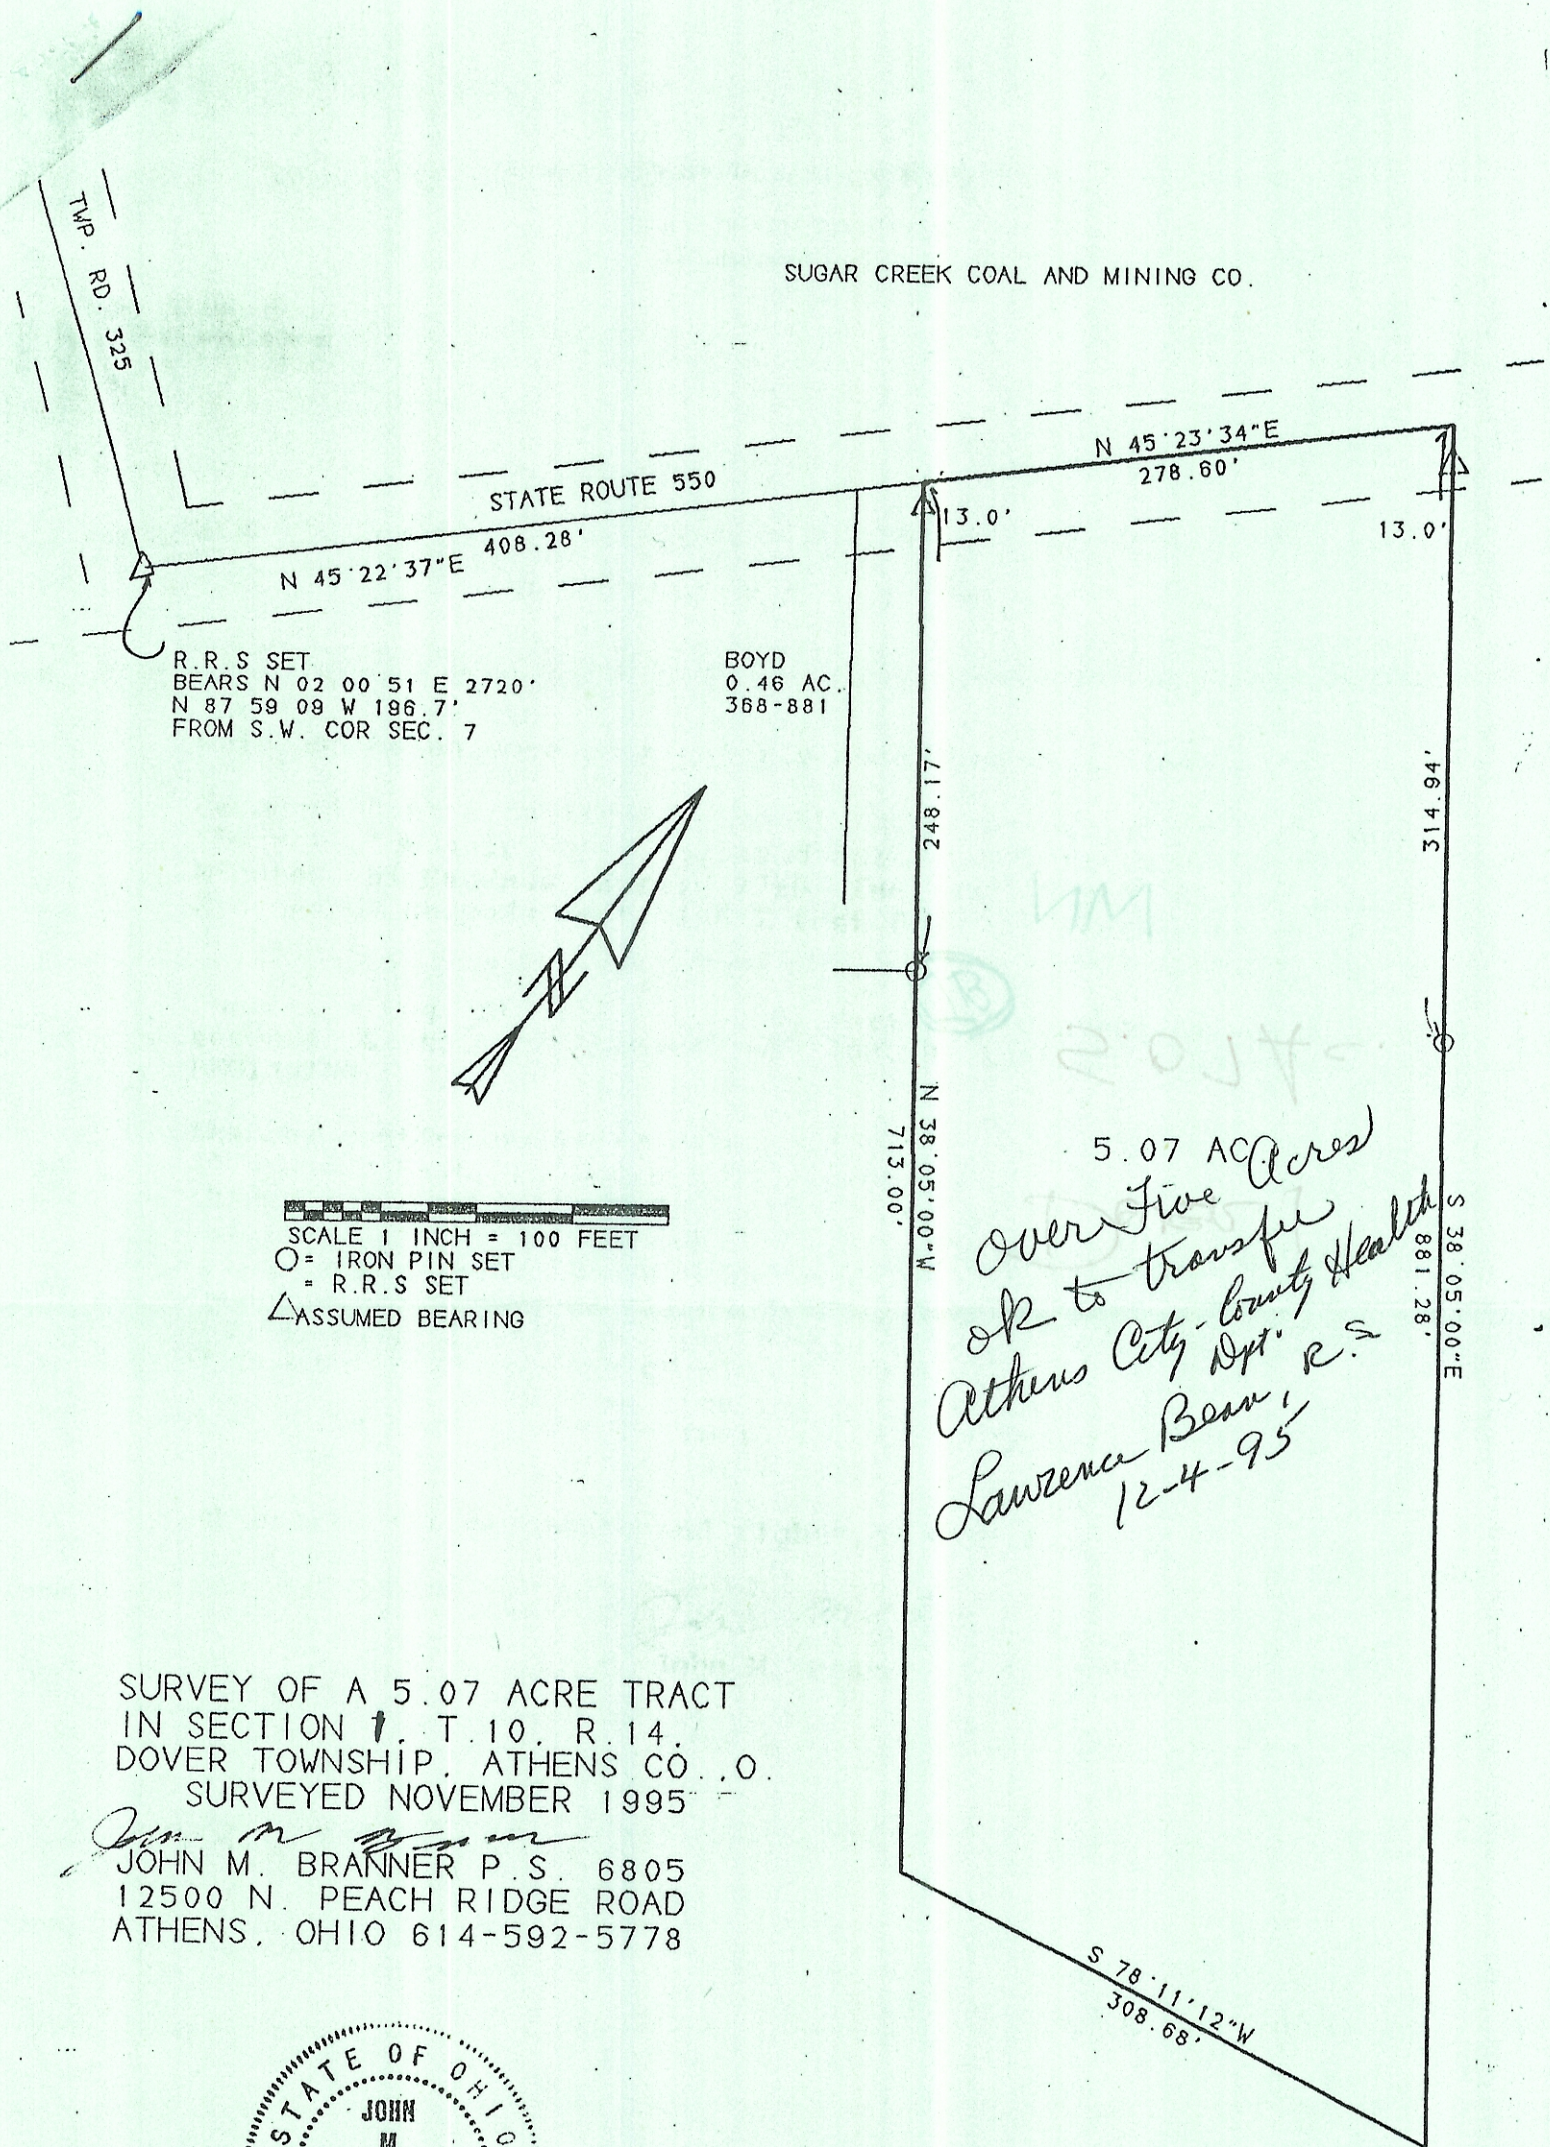


SUGAR CREEK COAL AND MINING CO.

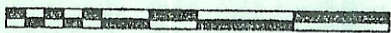

R.R.S SET
 BEARS N 02 00 51 E 2720'
 N 87 59 09 W 196.7'
 FROM S.W. COR SEC. 7

BOYD
 0.46 AC.
 368-881

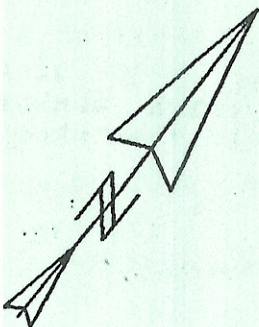


SCALE 1 INCH = 100 FEET
 O = IRON PIN SET
 = R.R.S SET
 Δ ASSUMED BEARING

*5.07 AC. Acres
 ok to transfer
 Athens City-County Health
 Lawrence Bean, R.S.
 12-4-95*

SURVEY OF A 5.07 ACRE TRACT
 IN SECTION 1, T. 10, R. 14,
 DOVER TOWNSHIP, ATHENS CO., O.
 SURVEYED NOVEMBER 1995

John M. Branner
 JOHN M. BRANNER P.S. 6805
 12500 N. PEACH RIDGE ROAD
 ATHENS, OHIO 614-592-5778

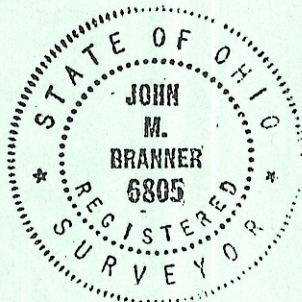

SUGAR CREEK COAL &
 MINING CO.
 84-227

3/4/95