


JERROLD E. SULLIVAN  
314-779

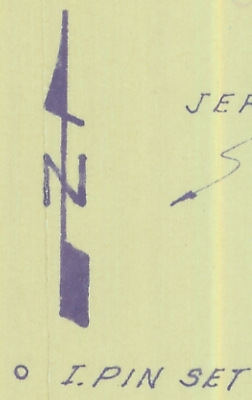

N 58° 11' 40" E  
214.98'

S 64° 21' 50" E  
200.03'

N 30° 21' 00" W  
97.76'

S 39° 55' 30" E  
210.24'

~~3.6268~~ Ac.  
3.7003

S 74° 57' 20" E  
177.84'

S 74° 57' 20" E  
20.43'

DELORES M.  
HUNTER  
200-234

N 49° 44' 30" W  
(D, N 49° W)  
330.00'

S 3° 11' 00" W  
157.91

LEO & PATRICIA  
HIXSON  
2581611

N 80° 22' 30" W  
(D, N 60° 30' W)  
219.78'

~~S 3° 11' 00" W  
162.09'~~

S.W. COR.  
SEC 1

16.16 CH. S 86° 3/4° E

N 86° 45' 00" W  
143.02'

20.00'  
COUNTY ROAD C-26

SCALE 1"=100'  
DEC. 1976

SECTION 1, T-10, R-14  
OHIO RIVER SURVEY  
DOVER TOWNSHIP  
ATHENS COUNTY  
OHIO

SURVEY FOR:  
JERROLD E. SULLIVAN

BY: GERALD E. HANN  
21 ELMWOOD PL.  
ATHENS, OHIO

Gerald E. Hann