Chauncey

1

Sec 20

N

Scale 1" = 20'

PLAT

of survey of inlot #219
in Village of chauncey Ohio
showing original Lot 219,
a strip, 33.0' wide, adjoining
the West side, and West of the
West side of said Lot, and
extending Northward to
the center of original sycamore
Street & being the East ½ of orig.
5th Street, Aban. by Ord #
Also a 33.0' strip, North of &
Adjoining the North line of said Lot
extending from 5th Street to the
West side of Converse street &
being the South ½ of Orig. Sycamore
Street Aban. by Ord. #
Also a portion of south ½ of orig. sycamore
street to be Q.C. to the Village of chauncey
to make sycamore street 50' in Width
from & old 5th street to West Line of
Converse street.

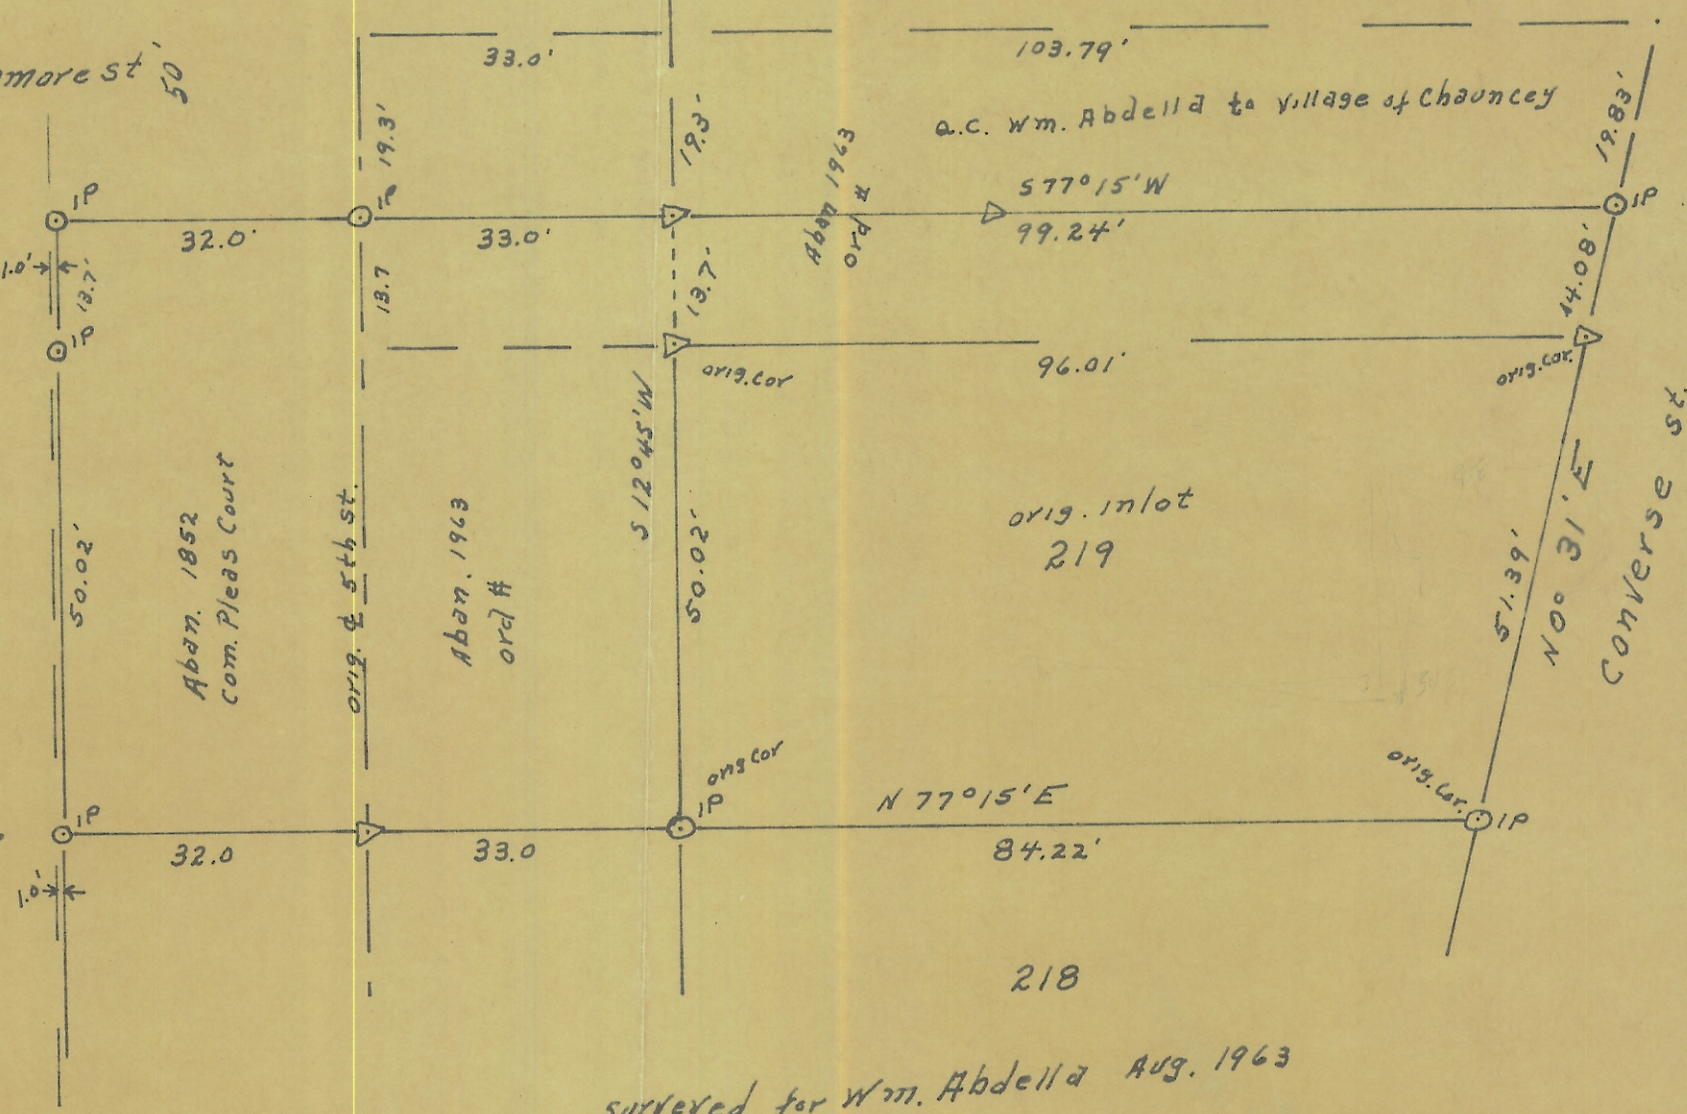

surveyed for Wm. Abdella Aug. 1963
by Joe L. Galvin
Reg. Sur. 1684

STATE OF OHIO
JOE A. GALVIN
1684
REGISTERED SURVEYOR