
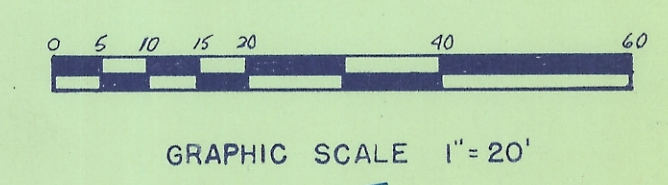


WATER ELEVATION

NORMAL	640.00'
HIGH WATER (3-5 YR)	656.00'
HIGH WATER (EXTREME)	659.00'

NOTE:
 I HEREBY CERTIFY THAT THE FOREGOING MAP WAS PREPARED FROM AN ACTUAL SURVEY OF THE PREMISES MADE UNDER MY SUPERVISION; THAT THE SAME SHOWS THE LOCATION OF THE BOUNDARIES, AND ALL IMPROVEMENTS THEREON; THAT THE DIMENSIONS OF THE IMPROVEMENTS AND THE LOCATION THEREOF WITH RESPECT TO THE BOUNDARIES ARE AS SHOWN; THAT THERE ARE NO ENCROACHMENTS BY IMPROVEMENTS APPURTENANT TO ADJOINING PREMISES UPON SUBJECT PREMISES, NOR FROM SUBJECT PREMISES UNLESS SHOWN ON THE PLAT; AND THAT ANY EASEMENTS APPARENT FROM A VISUAL INSPECTION ARE DELINEATED THEREON.

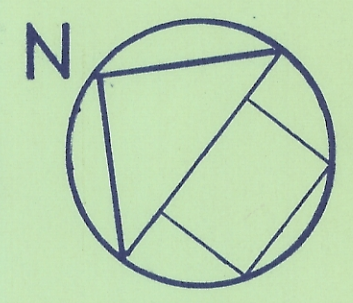

DATE 10-27-69	AUBLE MITCHELL BURGESS & ASSOCIATES ENGINEERS-ARCHITECT 4 W. STATE ST. ATHENS OHIO 45701
JOB NO. 1062-A	
DOVER TOWNSHIP ATHENS COUNTY OHIO	
PROPERTY SURVEY FOR MARATHON OIL CORPORATION	
ELEV. ON TOP OF RAIL 659.27'	

PROPERTY SURVEY 5722