

LINE TABLE		
LINE	BEARING	LENGTH
L1	N24°45'14"W	119.66'
L2	N84°16'31"W	65.00'

Existing home - no additional buildings made
 OK. to transfer
 per Athens City - Co
 Health Dept.


"sewage system application
 pending/casement from
 off-lot discharge will
 be simultaneously
 recorded with this
 plat"

Charles Kostival
 4/14/00

43,560 sq. ft.
 1.000 acres

Approved by the Athens
 County Regional Planning
 Commission; No plat
 Required"

Bob Schenberg
 Planning Director
 Date 4/14/00
 by PAM

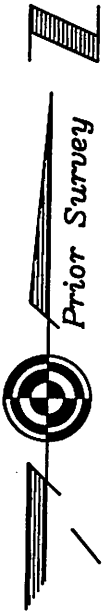

Prior Survey

Charles Paul & Maugarite
 Kostival
 280-40 OR

Charles Paul & Maugarite

Scale: 1" = 50'

Co. Rd. 10
 Twp. Rd. 15

Gregory K. Wright
 Professional Engineer
 Professional Surveyor

11684 Channingway Blvd
 The Plains, Ohio 45780
 740-797-4142
 FAX 740-797-8623

C:\Land Projects R2\PKostival\dwg\Dave White mtg.dwg 03/13/00 08:37:42 PM EST

I hereby declare that the foregoing was prepared from an actual mortgage survey of the premises and correctly shows the location of buildings and drives. THIS PLAT WAS PREPARED FOR MORTGAGE LOAN AND TITLE PURPOSES ONLY AND IS NOT TO BE CONSTRUED AS HAVING BEEN PREPARED FOR THE OWNER FOR ANY PURPOSE.

Owner: David White
 Property Address: 5340 Baker Road
 Athens, Ohio 45701

Located in Section 12, Lee Township, Athens County, Ohio


Gregory K. Wright



LINE TABLE		
LINE	BEARING	LENGTH
L1	N24°45'14"W	119.66'
L2	N84°16'31"W	65.00'

Existing home - no additional buildings and


OK to transfer
 per Athens City - Co
 Health Dept.
 "sewerage system application
 pending / easement from
 off-lot discharge will
 be simultaneously
 recorded w/ this
 plat"
 Charles Paul
 4/14/00

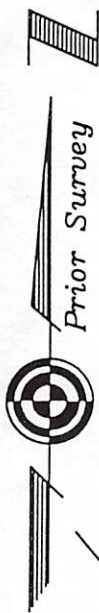

43,560 sq. ft.
 1.000 acres

Approved by the Athens
 County Regional Planning
 Commission; No plat
 Required"

Bob Schlenker
 Planning Director
 Date 4/14/00
 by PAM

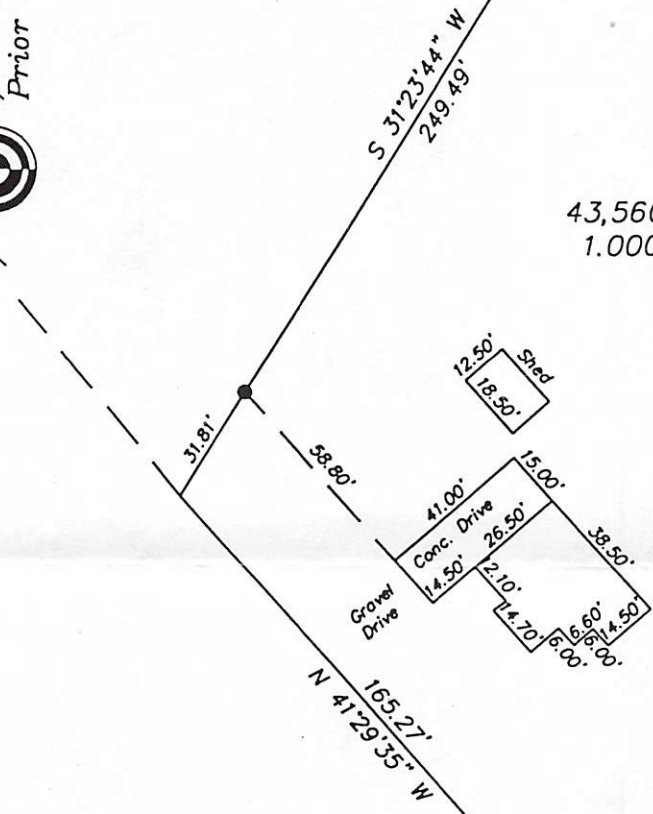

Charles Paul & Margarite
 Kostival
 280-40 OR

Charles Paul & Margarite

Gregory K. Wright
 Professional Engineer
 Professional Surveyor
 11684 Channingway Blvd
 The Plains, Ohio 45780
 740-797-4142
 FAX 740-797-8623

Scale: 1" = 50'

Co. Rd. 10
 Twp. Rd. 15

C:\Land Projects R2\PKostival\dwg\Dave White mtg.dwg 03/13/00 08:37:42 PM EST

I hereby declare that the foregoing was prepared from an actual mortgage survey of the premises and correctly shows the location of buildings and drives. THIS PLAT WAS PREPARED FOR MORTGAGE LOAN AND TITLE PURPOSES ONLY AND IS NOT TO BE CONSTRUED AS HAVING BEEN PREPARED FOR THE OWNER FOR ANY PURPOSE.

Owner: David White
 Property Address: 5340 Baker Road
 Athens, Ohio 45701
 Located in Section 12, Lee Township, Athens County, Ohio

Gregory K. Wright

