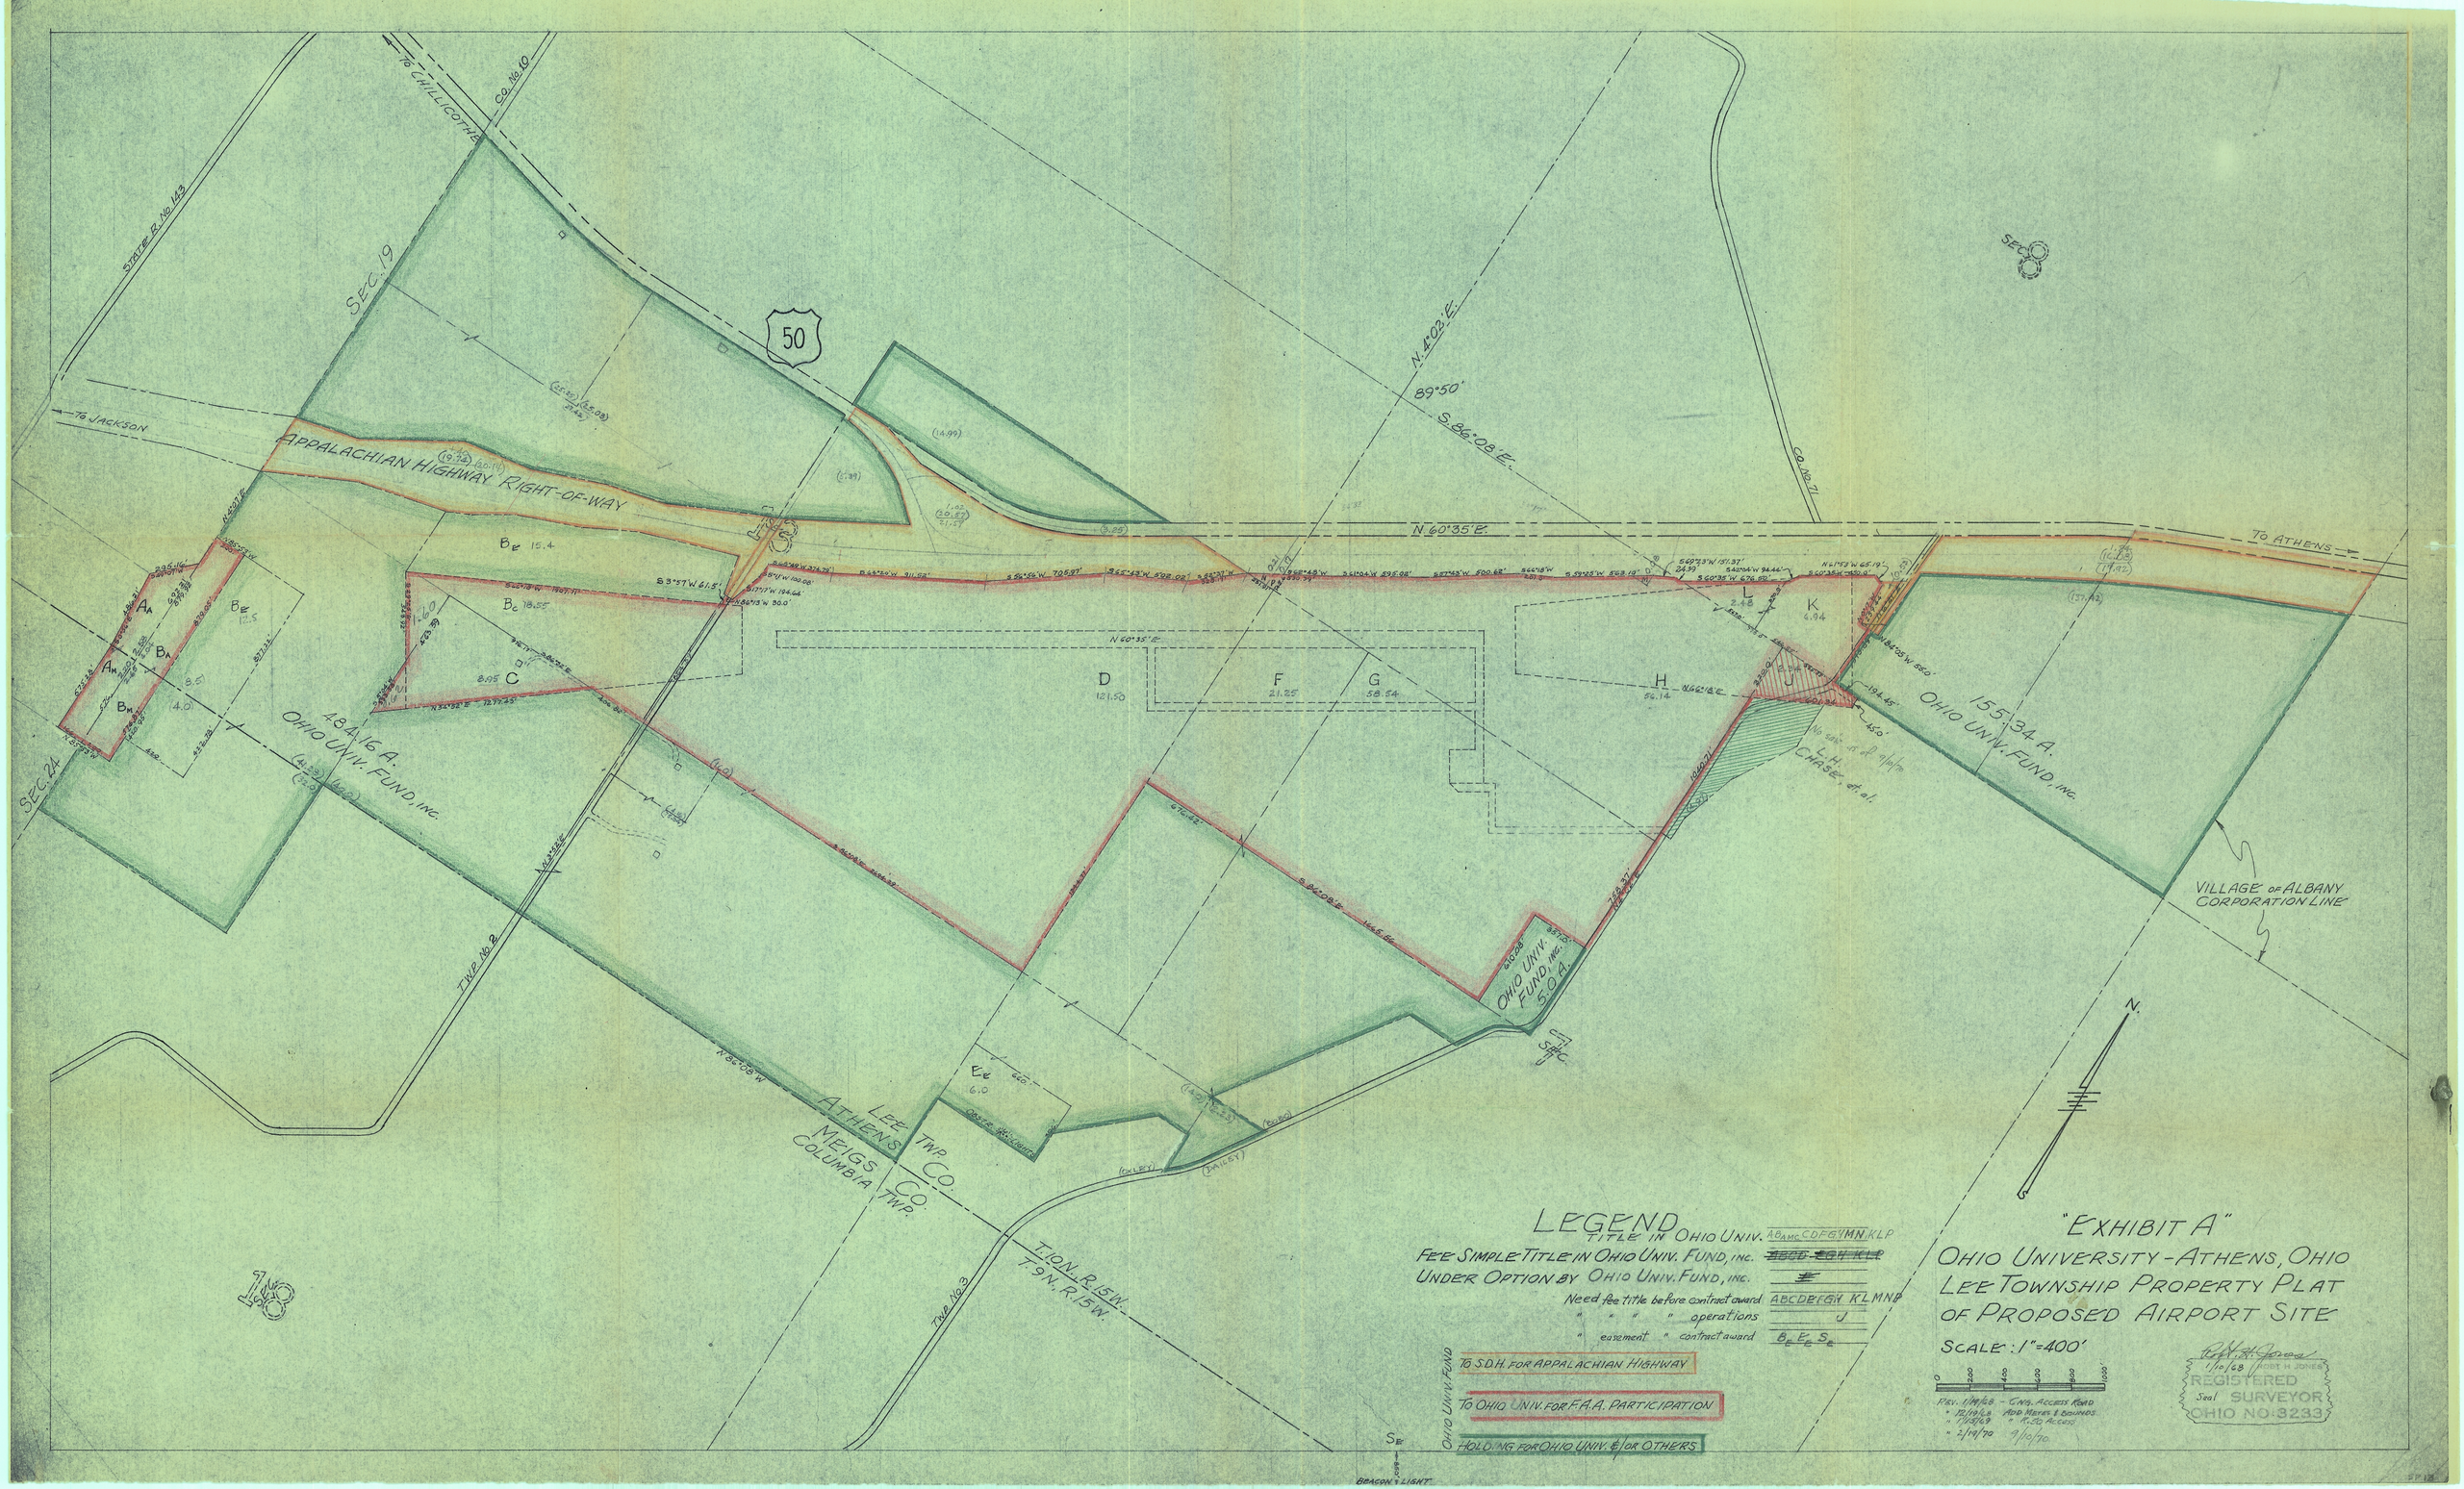

"EXHIBIT A"
OHIO UNIVERSITY - ATHENS, OHIO
LEE TOWNSHIP PROPERTY PLAT
OF PROPOSED AIRPORT SITE
SCALE: 1" = 400'
LEGEND
TITLE IN OHIO UNIV. ABAMC CDFGHMN KLP
FEE SIMPLE TITLE IN OHIO UNIV. FUND, INC. ~~ABCD EGH KLP~~
UNDER OPTION BY OHIO UNIV. FUND, INC. ~~E~~
Need fee title before contract award ABCDEFGH KLMNP
" " " " operations J
" easement " contract award BE EE SE
OHIO UNIV. FUND
TO S.D.H. FOR APPALACHIAN HIGHWAY
TO OHIO UNIV. FOR F.A.A. PARTICIPATION
HOLDING FOR OHIO UNIV. & / OR OTHERS
REV. 1/19/68 - CNG. ACCESS ROAD
" 12/10/68 ADD METES & BOUNDS
" 1/15/69 " R.50 ACCESS
" 2/19/70 9/10/70
1/10/68 ROBT H JONES
REGISTERED
Seal SURVEYOR
OHIO NO. 3233
TO CHILLICOTHE
CO. NO. 10
STATE R. NO. 143
SEC. 19
50
TO JACKSON
APPALACHIAN HIGHWAY RIGHT-OF-WAY
N. 60°35' E.
TO ATHENS
N. 4°02' E.
89°50'
S. 86°08' E.
CO. NO. 71
SEC. 24
484.16 A.
OHIO UNIV. FUND, INC.
155.34 A.
OHIO UNIV. FUND, INC.
L.H. CHASE, et al.
VILLAGE OF ALBANY CORPORATION LINE
OHIO UNIV. FUND, INC. 5.0 A.
LEE TWP.
ATHENS CO.
MEIGS CO.
COLUMBIA TWP.
T. 10 N., R. 15 W.
T. 9 N., R. 15 W.
TWP. NO. 2
TWP. NO. 3
BEACON & LIGHT