



C. THOMAS SMITH

and Associates Surveying

P. O. BOX 393

Racine, Ohio 45771

DESCRIPTION OF SURVEY FOR WILLIAM NOBLE

Being a part of an 80 acre± tract transferred to Carl Edward Puckett recorded as tract II in Deed Book 327 at Page 913, Athens County Recorder's Office, Athens County Ohio, also being a part of the West Half of the Southwest Quarter of Section 5, Township-4-North, Range-13-West, Lodi Township, Athens County, State of Ohio and more particularly described as follows:

Beginning at a stone assumed to be the Southwest corner of said Section 5, Township-4, Range-13;

Thence North $00^{\circ}35'35''$ East a distance of 748.40 feet to a 5/8" iron pin set;

Thence North $63^{\circ}21'22''$ East a distance of 863.80 feet to a railroad spike set in the centerline of County Road #47;

Thence along said centerline the following eleven courses:

1. South $06^{\circ}16'00''$ West a distance of 79.16 feet to a point; ✓
2. South $10^{\circ}18'00''$ West a distance of 262.95 feet to a point; ✓
3. South $09^{\circ}20'00''$ West a distance of 71.85 feet to a point; ✓
4. South $04^{\circ}49'56''$ West a distance of 93.77 feet to a point; ✓
5. South $00^{\circ}49'06''$ West a distance of 109.62 feet to a point; ✓
6. South $01^{\circ}55'05''$ East a distance of 145.37 feet to a point; ✓
7. South $06^{\circ}09'35''$ East a distance of 57.40 feet to a point; ✓
8. South $13^{\circ}49'05''$ East a distance of 52.71 feet to a point; ✓
9. South $28^{\circ}03'56''$ East a distance of 62.10 feet to a point; ✓
10. South $37^{\circ}44'51''$ East a distance of 112.80 feet to a point; ✓
11. South $38^{\circ}29'19''$ East a distance of 169.28 feet to a point; ✓

Thence leaving said centerline North $89^{\circ}39'05''$ West passing thru a 5/8" iron pin set at a distance of 100.00 feet and going a total distance of 930.31 feet to the principal point of beginning containing 16.024 acres± subject to all legal easements and rights-of-way.

Bearings were derived from a previous survey recorded in Deed Book 375 at Page 721.

The above description was prepared from an actual survey made on the 4th day of November, 1997, by C. Thomas Smith, Ohio Professional Surveyor, #68444.

C. Thomas Smith, P.S. #6844

Description checked for
Mathematical Accuracy
ATHENS COUNTY
ENGINEER'S OFFICE

BY: S. Blausen

DATE: 4-16-99

32
Lodi #5



C. THOMAS SMITH and Associates Surveying

P. O. BOX 393
Racine, Ohio 45771


BEING A PART OF THE WEST HALF OF THE SOUTHWEST
QUARTER OF SECTION 5, T-4-N, R-13-WEST, Lodi
TOWNSHIP, ATHENS COUNTY, STATE OF OHIO.

NOTE: BEARINGS WERE DERIVED FROM A
PREVIOUS SURVEY RECORDED IN D.B. 375
AT PAGE 721

LEGEND

- 5/8" IRON PIN SET
- ▲ RAILROAD SPIKE SET
- EXISTING STONE
- POINT

Description checked for
Mathematical Accuracy
ATHENS COUNTY
ENGINEER'S OFFICE
BY: S. Blaise
DATE: 4-16-99

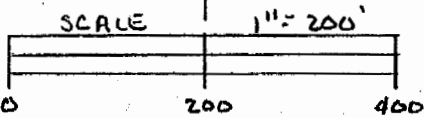

BRYON & CAROL JAMES
327-365

SEC 11
SEC 5

N 63° 21' 22" E

863.80'

S 06° 16' 00" W
79.16'

S 16° 18' 00" W
262.95'

S 09° 20' 00" W
71.85'

S 04° 49' 56" W
93.77'

S 00° 49' 06" W
109.62'

S 01° 55' 05" E
145.37'

S 06° 09' 35" E
57.40'

S 13° 49' 05" E
52.71'

S 28° 03' 56" E
62.10'

S 37° 44' 51" E
112.80'

S 38° 29' 19" E
169.28'

ERNIN & FRANCES PUCKETT
375-721

16.024 ACRES ±

CARL EDWARD PUCKETT
327-913

SW COR
SEC 5
T-4, R-13

N 89° 39' 09" W
830.31'

SEC 5
SEC 4
930.31'

DONALD R. BRADLEY ETAL
382-637 & 639

DELBERT & DONA MARKS
116-389

REFERENCES
CURRENT TAX PLATS
PREVIOUS SURVEYS
DEEDS; AS NOTED

PLAT PREPARED FROM AN ACTUAL SURVEY MADE ON
THE 4th DAY OF NOVEMBER, 1997 BY,

C. Thomas Smith

OHIO PROFESSIONAL SURVEYOR

35

No. 6244