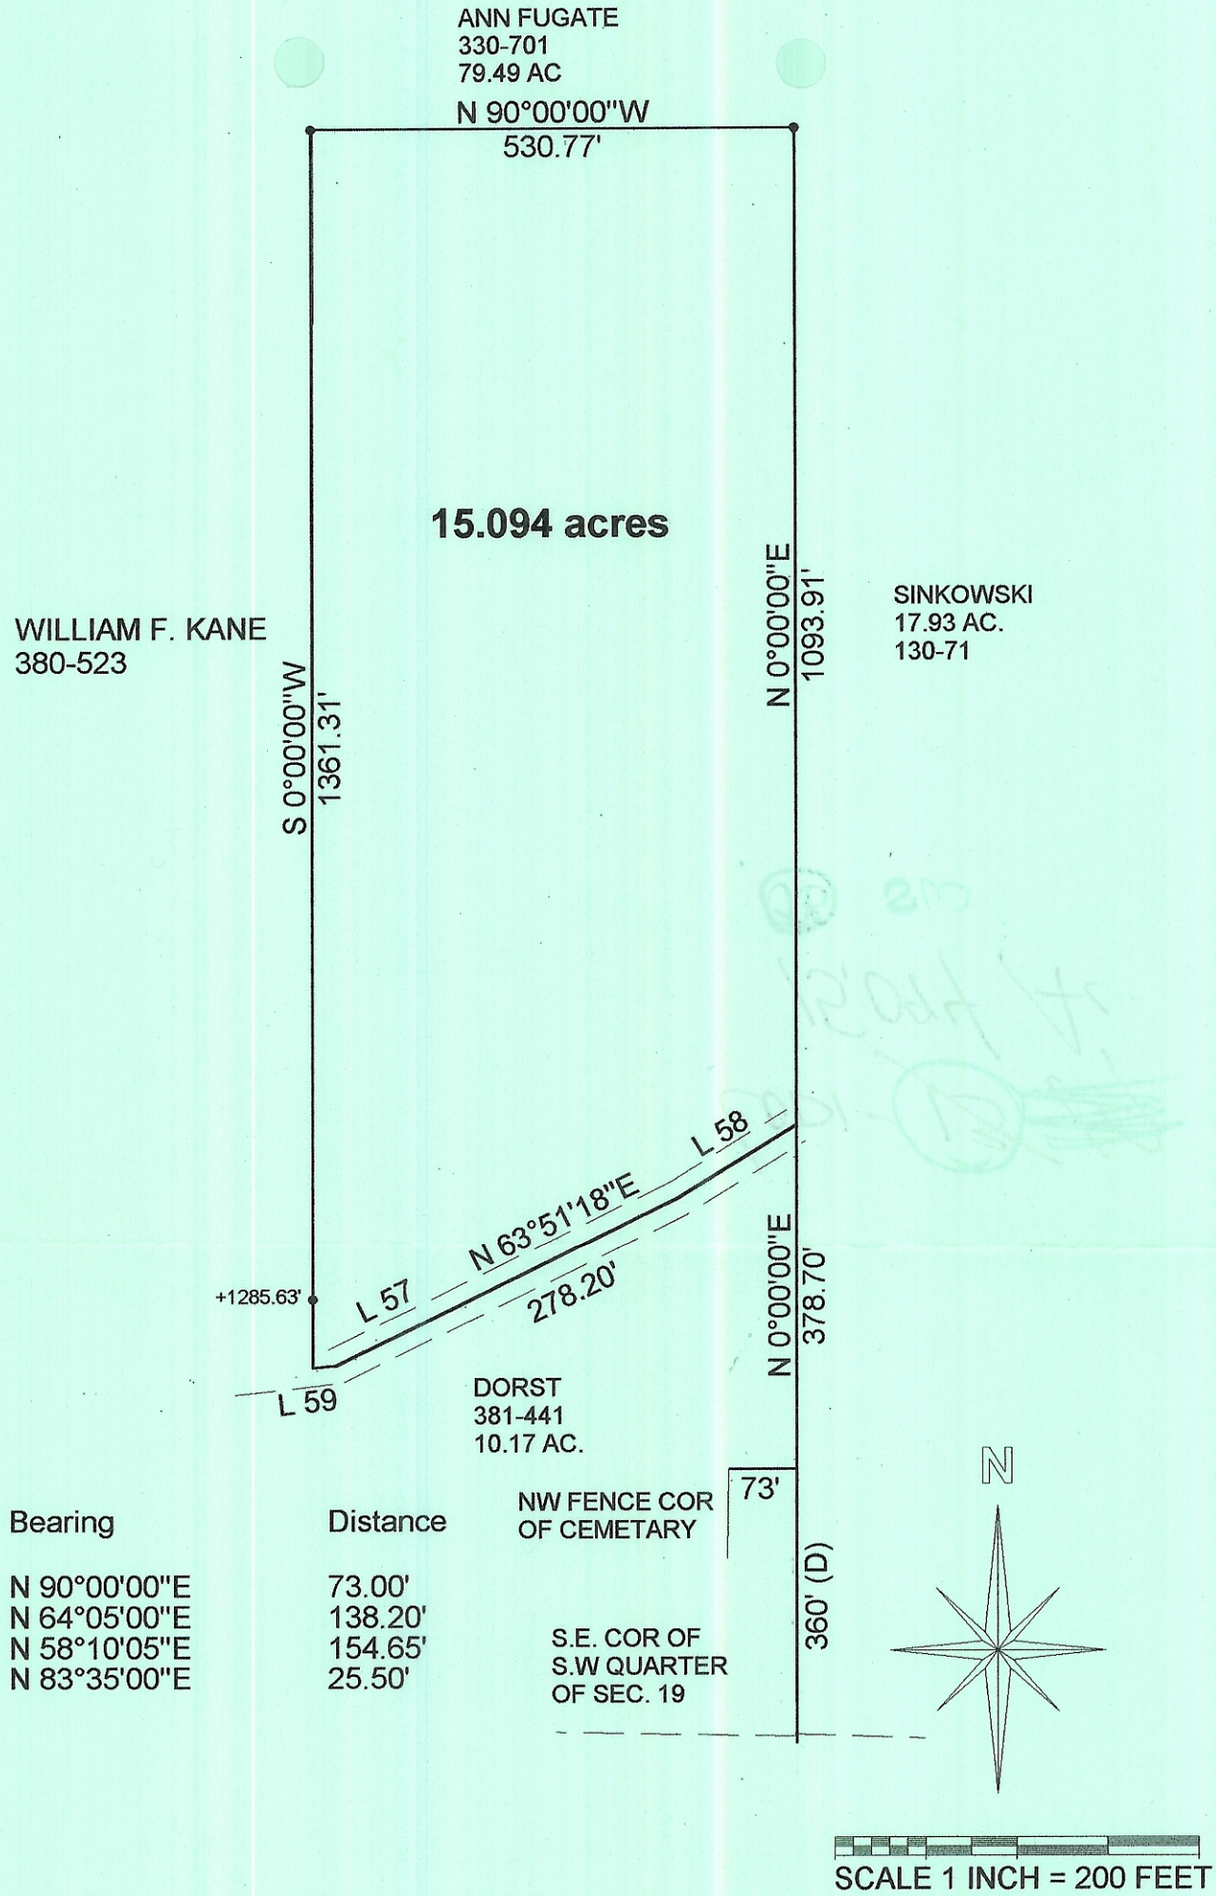

Line	Bearing	Distance
56	N 90°00'00"E	73.00'
57	N 64°05'00"E	138.20'
58	N 58°10'05"E	154.65'
59	N 83°35'00"E	25.50'

SURVEY OF A 15.094 ACRE TRACT
SECTION ~~13~~ 19, T.4, R.13, LODI TOWNSHIP
ATHENS COUNTY, OHIO
SURVEYED MARCH 2001

BY:_____

JOHN M. BRANNER P.S. 6805
12500 N. PEACH RIDGE ROAD
ATHENS, OHIO 45701
(740) 592-5778

STATE OF OHIO
John
M.
Branner
S-6805
REGISTERED
SURVEYOR

Description checked for
Mathematical Accuracy
ATHENS COUNTY
ENGINEER'S OFFICE
BY: S. Blauser
DATE: 3-22-01