Plat of Parcels Surveyed

Out of

Edith Moore's

Volume 217, Page 550, 2nd and 3rd Tracts

Lodi Twp., Athens Co., Ohio

Section 16, T 4, R 13

Scale 1" = 200'

200' | 100' | 100'

⊡ = Corner Stone Found

⊙ = 5/8" Rebar 30" long with Cap Set

—x—x— = Fence Line

Reference Deed: Volume 217-550
2nd and 3rd Tract

2nd Tract: Deed Ac. = 22.76 Ac.
Survey Ac. = 20.251 Ac.

3rd Tract: Deed Ac. = 2.00 Ac.
Survey Ac. = 3.202 Ac.

Note: 2nd Tract Does Not Close by 182.48'

Note: No Easements or Rights of Way Shown

Bearings Based on Ref. Deed; North Line of 2nd Tract; Assumed and are for Angle Measurement only.

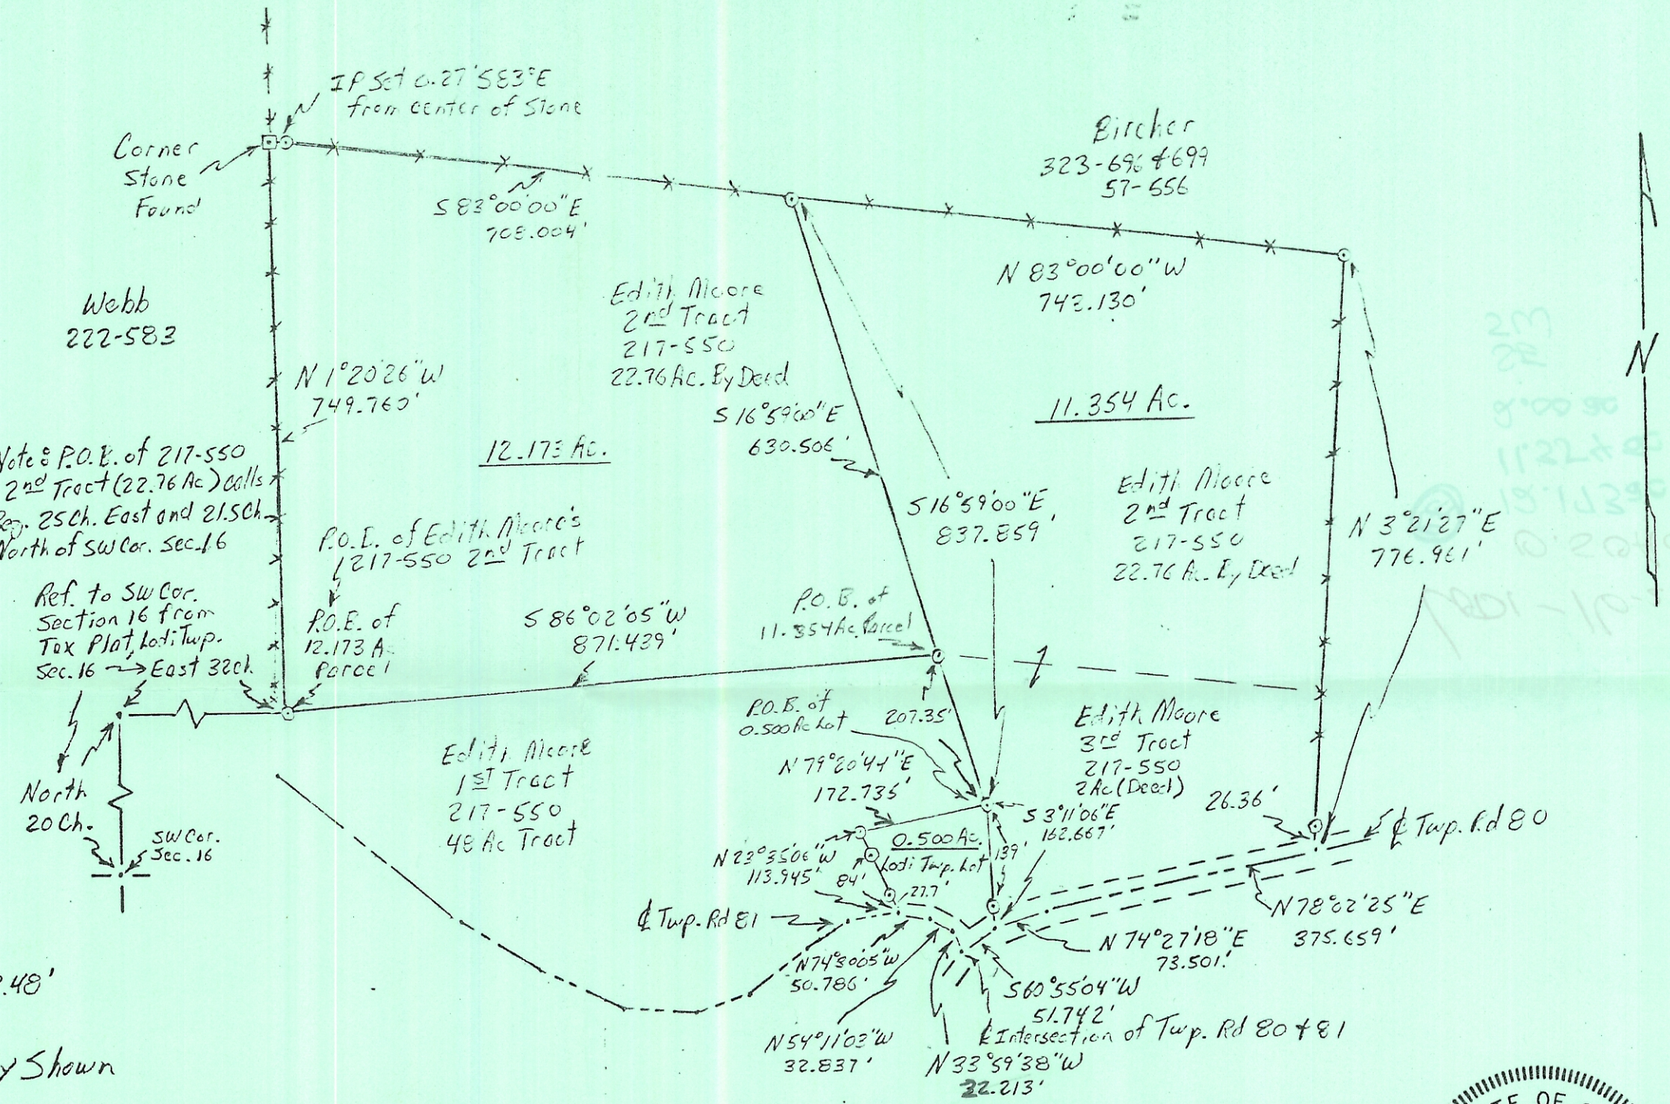

Note: 0.500 Acre Lodi Township Lot as Shown on This Plat is the Agreed Location and is subject to Agreement Between Lodi Township Trustees and Edith Moore.

STATE OF OHIO
ROBERT R. EASON
7033
REGISTERED
PROFESSIONAL SURVEYOR

Robert R. Eason

Nov, 1993