

COWAN ROAD

SONDRA SINCLAIR  
1.28 AC.  
330-687

FENCE LINE  
APPROX BDRY LOCATION


JOHN S. BLAZIER  
134.69 AC.  
237-365 O.R.

N 79°01'28"E  
1307.29'

10.00 Acres

FRANK DEWEY KING  
75.81 AC,  
347-830 O.R.

Reference Documents  
Prior Surveys  
Tax -Plat  
Deeds  
ASSUMED BEARING TO  
BE USED FOR INTERIOR ANGLES ONLY

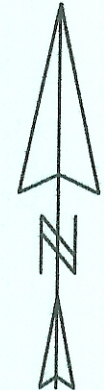

SURVEY OF A 10.00 ACRE TRACT  
IN FR. 33, SECTION 27 T.4N., R.13 W  
LODI TOWNSHIP, ATHENS COUNTY, OHIO

SURVEYED NOVEMBER 2007  
*John M. Branner*  
JOHN M. BRANNER P.S. 6805  
12500 N. PEACH RIDGE ROAD  
ATHENS, OHIO 45701  
740-592-5778

MARK S. AND PAM DOUGLAS  
11.83 AC.  
361-695 O.R.

S 85°48'47"W  
1183.62'

+25.40'

+1164.33'

S 11°03'15"E  
426.14'


+1080.00

S 89°19'32"W  
1098.83'

S 0°00'00"E  
427.84'

S 0°00'00"E  
491.72'

STONE FD.  
BEARS SOUTH 2543.5' (DEED)  
FROM N.E. COR. OF FR. 33

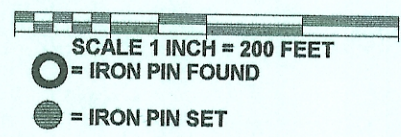

Description Checked for  
Mathematical Accuracy  
Athens County  
ENGINEER'S OFFICE  
BY: *J. Blaus*  
DATE: 11-20-07

875 2150