


Athens County Commissioners

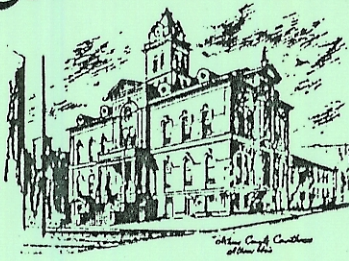

KAREN HARVEY
ROXANNE GROFF
DEAN R. KAHLER

VADA POSTON
CLERK

TELEPHONE (614) 593-7988

ATHENS, OHIO 45701

October 23, 1985

The Athens Messenger
Route 33 N at Johnson Rd.
Athens, Ohio 45701

LEGAL NOTICE


The Board of Athens County Commissioners having been petitioned to approve the following changes in Marydale Subdivision, situated in Section 25, Athens Township:

1. Vacate "Marydale Court" which is approximately 890.39 feet in length
 2. Return lots 53 thru 65 to acreage
- will conduct a public viewing of same at 11:30 a.m., November 19, 1985.
A public hearing will be held in the Commissioners' Meeting Room, Courthouse, Athens, at 2:00 p.m., November 19, 1985, to consider the matter.

Board of Athens County Commissioners
Vada Poston, Clerk

Marydale Court

Publish: 10/29

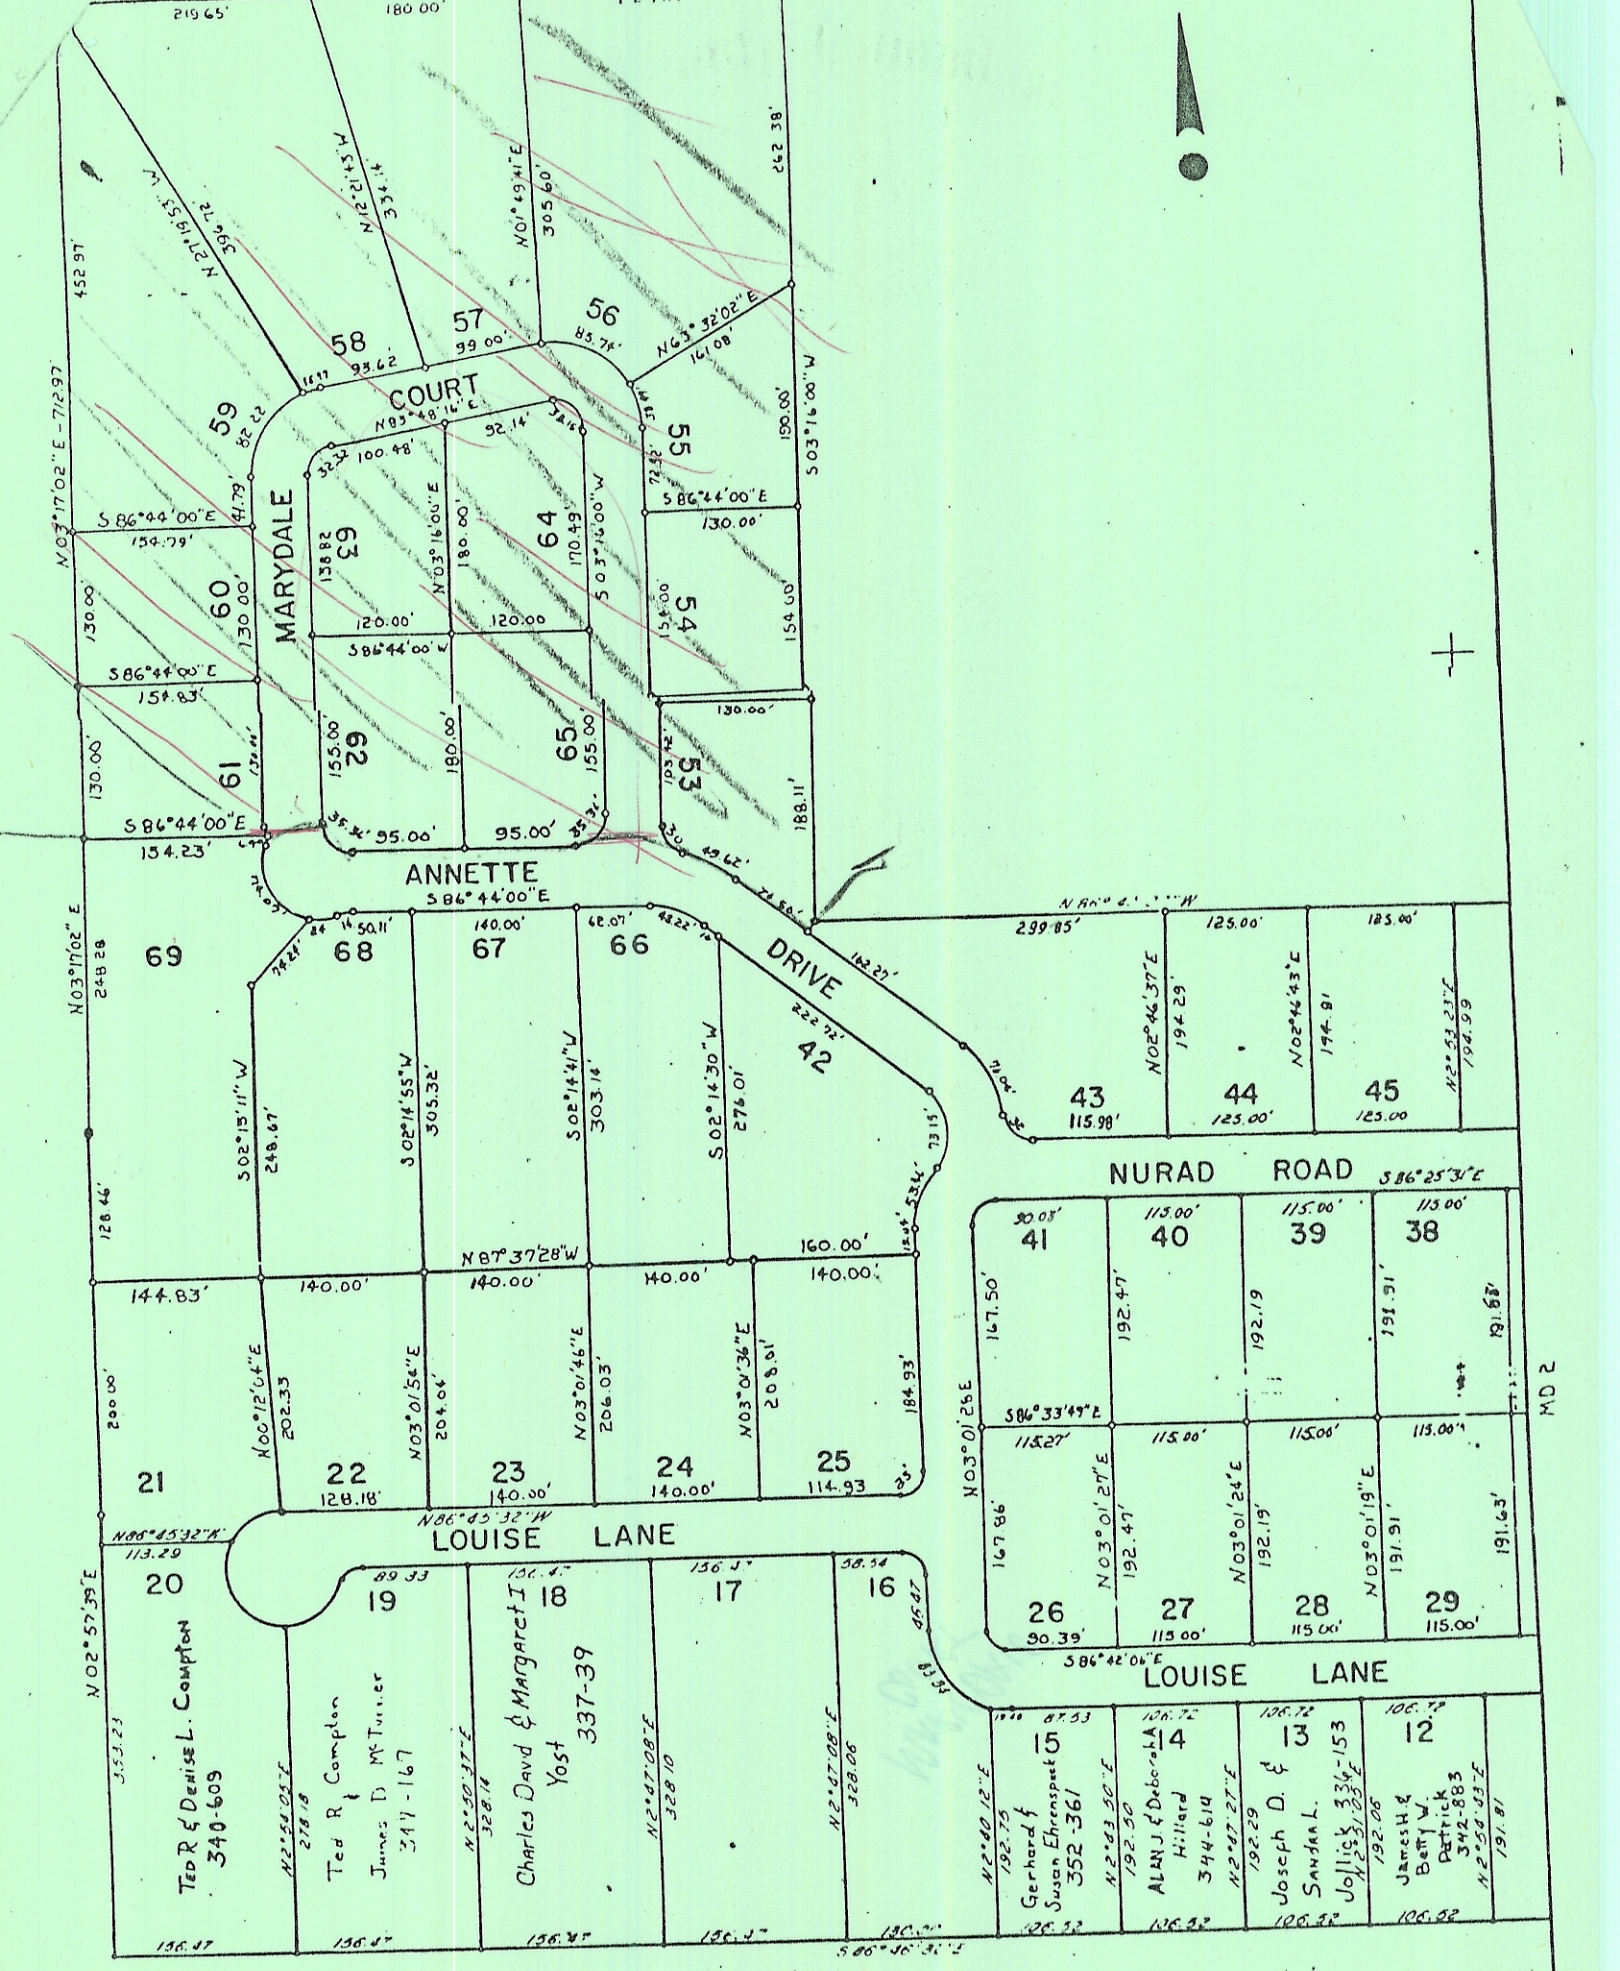

TED R & DENISE L. COMPTON
340-609

Ted R. Compton
James D. McTurner
347-167

Charles David & Margaret I. Yost
337-39

Gerhard & Susan Ehrenspick
352-361

ALAN J. & DEBORAH A. Hillard
344-610

Joseph D. & SANDRA L. Jollick
336-153

James H. & Betty W. Patrick
342-883

MD 2