ENVELOPE: 328B

PROPOSED ADDITION TO CITY OF ATHENS -
FARM LOTS 43-46-47-48

275

PLAT OF

PROPOSED ADDITION TO CITY OF ATHENS OHIO

As plotted by me this 25 day of July 1955

Joe L. Galvin
Joe L. Galvin
Reg. Sur. 1684

APPLICATION FOR ANNEXATION OF TERRITORY ADJOINING THE CITY OF ATHENS, OHIO AND DESCRIBED IN PROCEEDINGS OF ATHENS COUNTY COMMISSIONERS JOURNAL, VOL ____ PAGE ____
_____, 19__

ACCEPTED BY THE COUNCIL OF CITY OF ATHENS, OHIO BY ORDINANCE No ____ DATED _____ 19__
AND RECORDED IN CITY COUNCIL ORDINANCE BOOK VOL ____ PAGE ____
CERTIFIED BY _____
CLERK OF CITY COUNCIL

Signatures of petitioning resident property owners seeking annexation of property to the CITY OF ATHENS OHIO
Date _____ 19__
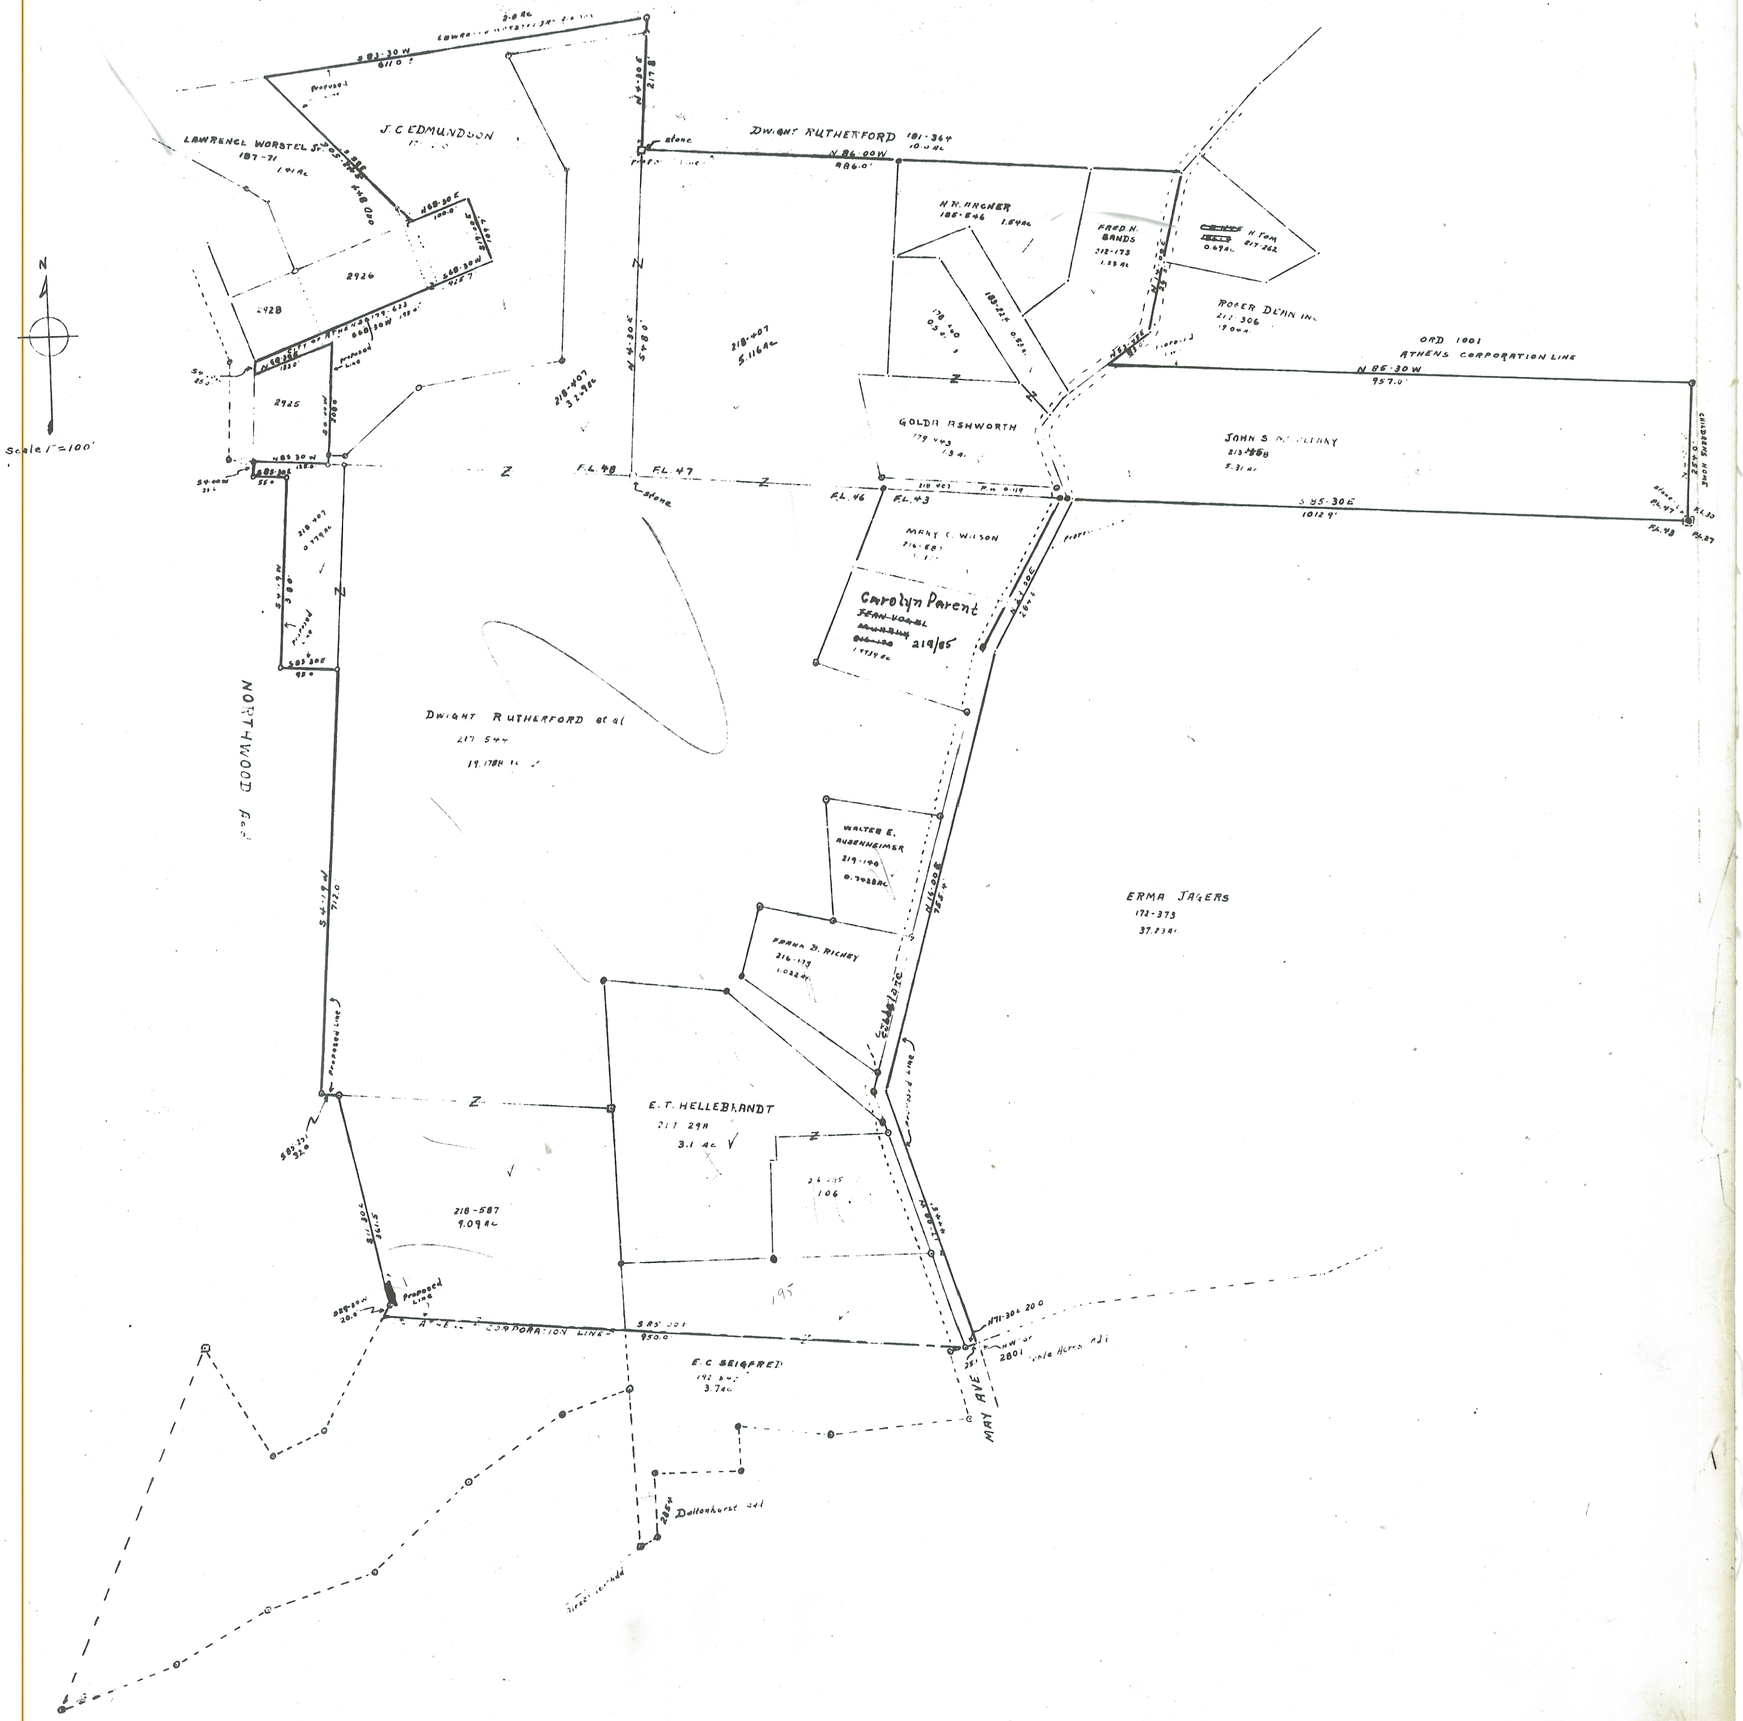
Consent granted that property described in petition filed _____ 19__ may be annexed to the CITY OF ATHENS, OHIO in accordance with law, as ordered _____ 19__
Commissioners Journal Vol. ___ page ___
Certified by
Clerk of Board of Athens Co. Comm.