

Carles Miller  
221-143 OR

CURVE TABLE			
CURVE	RADIUS	CHORD BEARING	CHORD LENGTH
C1	558.20'	S 70°50'14" E	473.06'
C2	415.40'	N 73°29'15" E	468.19'

LINE TABLE		
LINE	LENGTH	BEARING
L1	169.28	S36°04'46"E
L2	298.51	N41°33'58"W
L3	141.87	N48°35'17"W
L4	344.26	N51°43'59"W
L5	192.50	N54°10'52"W
L6	376.09	S03°18'00"E
L7	85.13	S28°57'12"E
L8	270.33	S45°45'59"E
L9	248.46	S44°49'46"E
L10	322.52	S72°12'43"E
L11	84.93	N39°11'13"E
L12	177.75	S32°02'32"E
L13	179.52	S38°47'32"E
L14	266.64	S46°12'28"W
L15	80.31	S33°12'28"W
L16	135.35	S62°47'51"W
L17	230.93	N77°18'00"W
L18	293.48	N34°09'03"W
L19	111.79	N89°12'28"W
L20	160.14	S82°55'43"W
L21	190.21	S48°47'25"W
L22	308.58	S46°58'18"W
L23	152.74	N77°45'15"W
L24	382.80	N46°12'28"E


**Plat of Survey of Two Tracts  
Situated in Sections 26 and 32, Town 6,  
Range 12, Rome Township, Athens County,  
Ohio**  
Surveyed April 2008 for:  
**Matt Starline**

*Charles T. Newman*  
**Charles T. Newman**

Jeffrey J. Jacobs  
113-754 OR

Description Checked for  
Mathematical Accuracy  
Athens County  
**ENGINEER'S OFFICE**  
BY: *S. Blause*  
DATE: *4-7-08*

- △ = Railroad Spike Found
- ▲ = Railroad Spike Set
- ⊙ = Iron Pin Found
- = Iron Pin Set

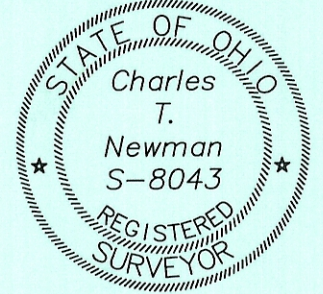

Member of Professional Land Surveyors of Ohio Land Surveys, Subdivisions

**C. TIM NEWMAN**  
Professional Surveyor

66 Elmwood Place Athens, Ohio 45701 740-594-1884  
FAX 740-594-9413

