

SECTION 13
SECTION 7

DENNIS L. AND
PATRICIA M. SNEDDEN
O.R. VOL. 17 PG. 120

JAY D. AND
WENDY C. PROFFITT
O.R. VOL. 26 PG. 480

DENVER D.
LIGHTNER
O.R. VOL. 60 PG. 736
O.R. VOL. 245 PG. 706

NEW PARCEL
24.8005 ACRES

SOURCES OF DATA:
ATHENS COUNTY TAX MAPS
ATHENS COUNTY OFFICIAL RECORDS
ATHENS COUNTY DEED RECORDS
PREVIOUS SURVEYS

ROBERT L. AND
PATRICIA E. BARNHART
D.R. VOL. 329 PG. 179 & 181
D.R. VOL. 371 PG. 093

JERRY L.
PROFFITT
O.R. VOL. 83 PG. 788
O.R. VOL. 85 PG. 821

Description checked for
Mathematical Accuracy
ATHENS COUNTY
ENGINEERS OFFICE
BY: *K. Lantieri*
DATE: 10/21/99

ROBERT AND
DONNA JEAN BUCK
D.R. VOL. 361 PG. 621


SHERYL D. LEUSCHEL
O.R. VOL. 233 PG. 410

RONALD L. AND PAULA L.
DUNFEE
O.R. VOL. 47 PG. 672

N 00°02'00" E
660.00' (BY DEED)

S.W. CORNER OF
THE N.W. QUARTER
OF ROME TWP. SEC. 7

COUNTY ROAD 53
BETHANY RIDGE ROAD

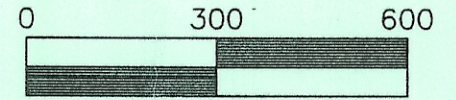


Scale 1" = 300'

- IRON PIN SET BY THIS SURVEY: 5/8" X 30" REBAR W/PLASTIC I.D. CAP: E. TRIPLETT S-6766.
- IRON PIN FOUND BY THIS SURVEY.
- ⊕ RAILROAD SPIKE FOUND BY THIS SURVEY.
- ⊙ STONE FOUND BY THIS SURVEY.

BEARINGS ARE ASSUMED AND ARE USED TO EXPRESS
ANGULAR MEASUREMENT ONLY.

TRIPLETT ENGINEERING SERVICES

P.O. Box 449
Pomeroy, Ohio 45769
(740) 992-2194

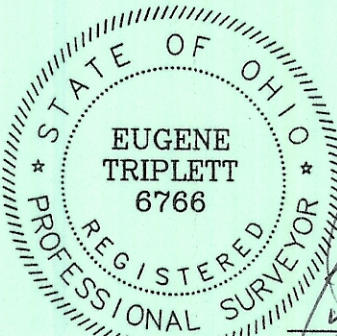

Surveyed by:

Eugene Triplett, P.S. No. 6766

SURVEY OF A NEW PARCEL CREATED OUT OF
THE JAY D. AND WENDY C. PROFFITT PROPERTY
ATHENS COUNTY OFFICIAL RECORDS VOL. 26 PG. 480
ROME TOWNSHIP, ATHENS COUNTY, STATE OF OHIO
SECTION 7, TOWNSHIP 6, RANGE 12
OHIO COMPANY PURCHASE
DATES OF SURVEY: OCTOBER 12 AND 18, 1999

Date: OCTOBER 18, 1999 Scale: 1" = 300'

Drawn by: M.B.C. Checked by: E.T.