

- △ = Railroad Spike Found
- ▲ = Railroad Spike Set
- ⊙ = Iron Pin Found
- = Iron Pin Set

LINE TABLE		
LINE	LENGTH	BEARING
L1	20.17	S61°27'02"W
L2	8.97	S06°27'02"W
L3	13.86	N06°27'02"E
L5	19.84	S57°51'11"E
L6	16.62	N11°57'02"E



CURVE TABLE			
CURVE	RADIUS	CHORD BEARING	CHORD LENGTH
C1	1749.31'	S 58°35'09" E	19.42'

Note:  
All names and deed references are according to current Athens County Auditor Tax Plats.

Plat of Survey of 2 Tracts  
Situating in Section 25, Town 11,  
Range 14, Trimble Township,  
Athens County, Ohio  
Surveyed April 2006 for:  
Gary Brooks

*Charles T. Newman*  
Charles T. Newman

Description Checked for  
Mathematical Accuracy  
Athens County  
ENGINEER'S OFFICE  
BY: *S. Blouse*  
DATE: *5-3-06*

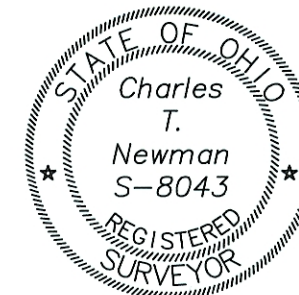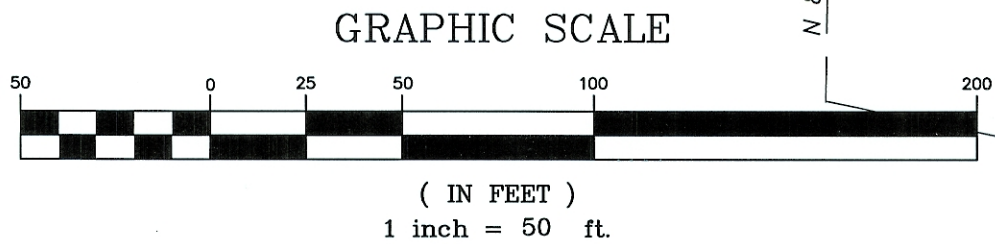

Member of Professional Land Surveys, Subdivisions  
Land Surveyors of Ohio

**C. TIM NEWMAN**  
Professional Surveyor

66 Elmwood Place Athens, Ohio 45701 740-594-1884 FAX 740-594-9413