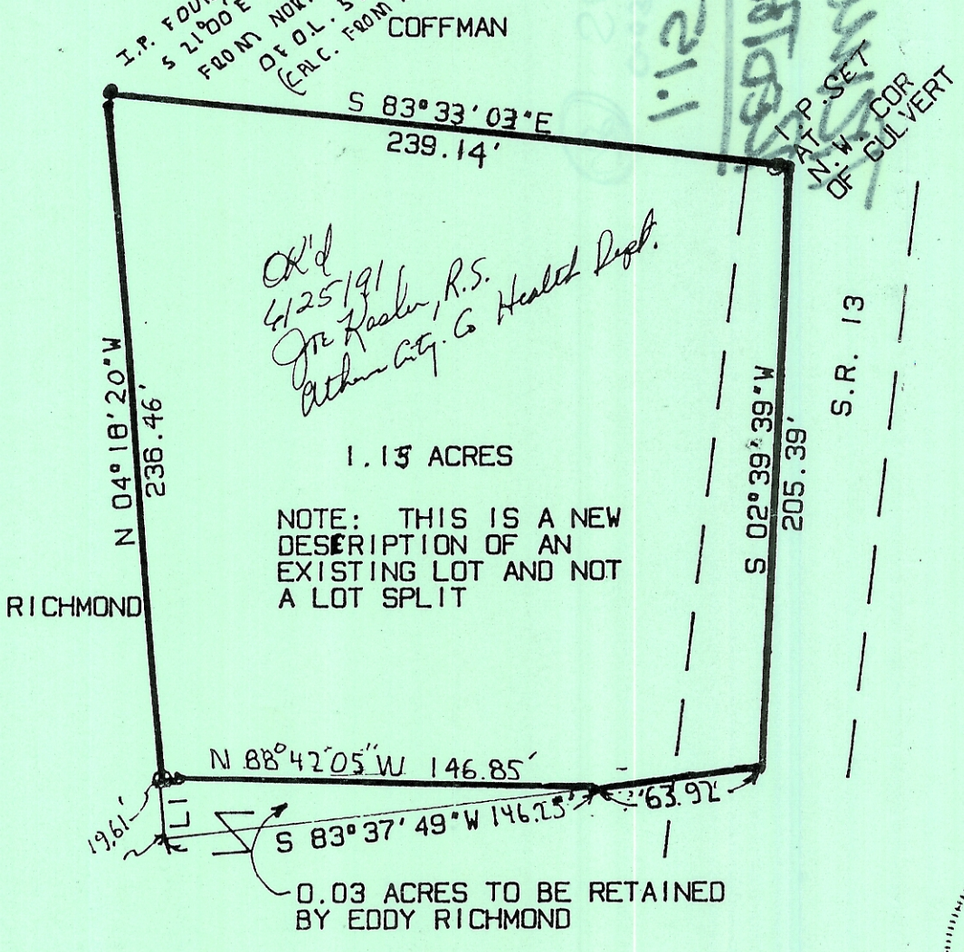

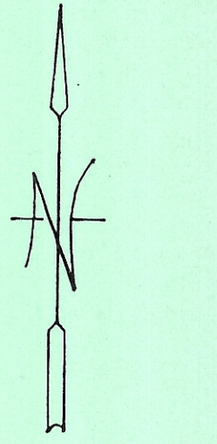

SCALE 1"=60'
● = IORN PIN FOUND
= IRON PIN SET

SURVEY OF A 1.15 ACRE
TRACT AND A 0.03 ACRE
TRACT IN O.L. 57. SECT.
7. T.11. R. 14 TRIMBLE
TOWNSHIP. ATHENS CO. O.
SURVEYED JONE 1991

John M. Branner

JOHN M. BRANNER P.S. 6805
12500 N. PEACH RIDGE ROAD
ATHENS. OHIO 592-5778

STATE OF OHIO
JOHN
M.
BRANNER
6805
REGISTERED
SURVEYOR

1.90 Ac.
ATH
24
LL-113