


PLAT OF SURVEY

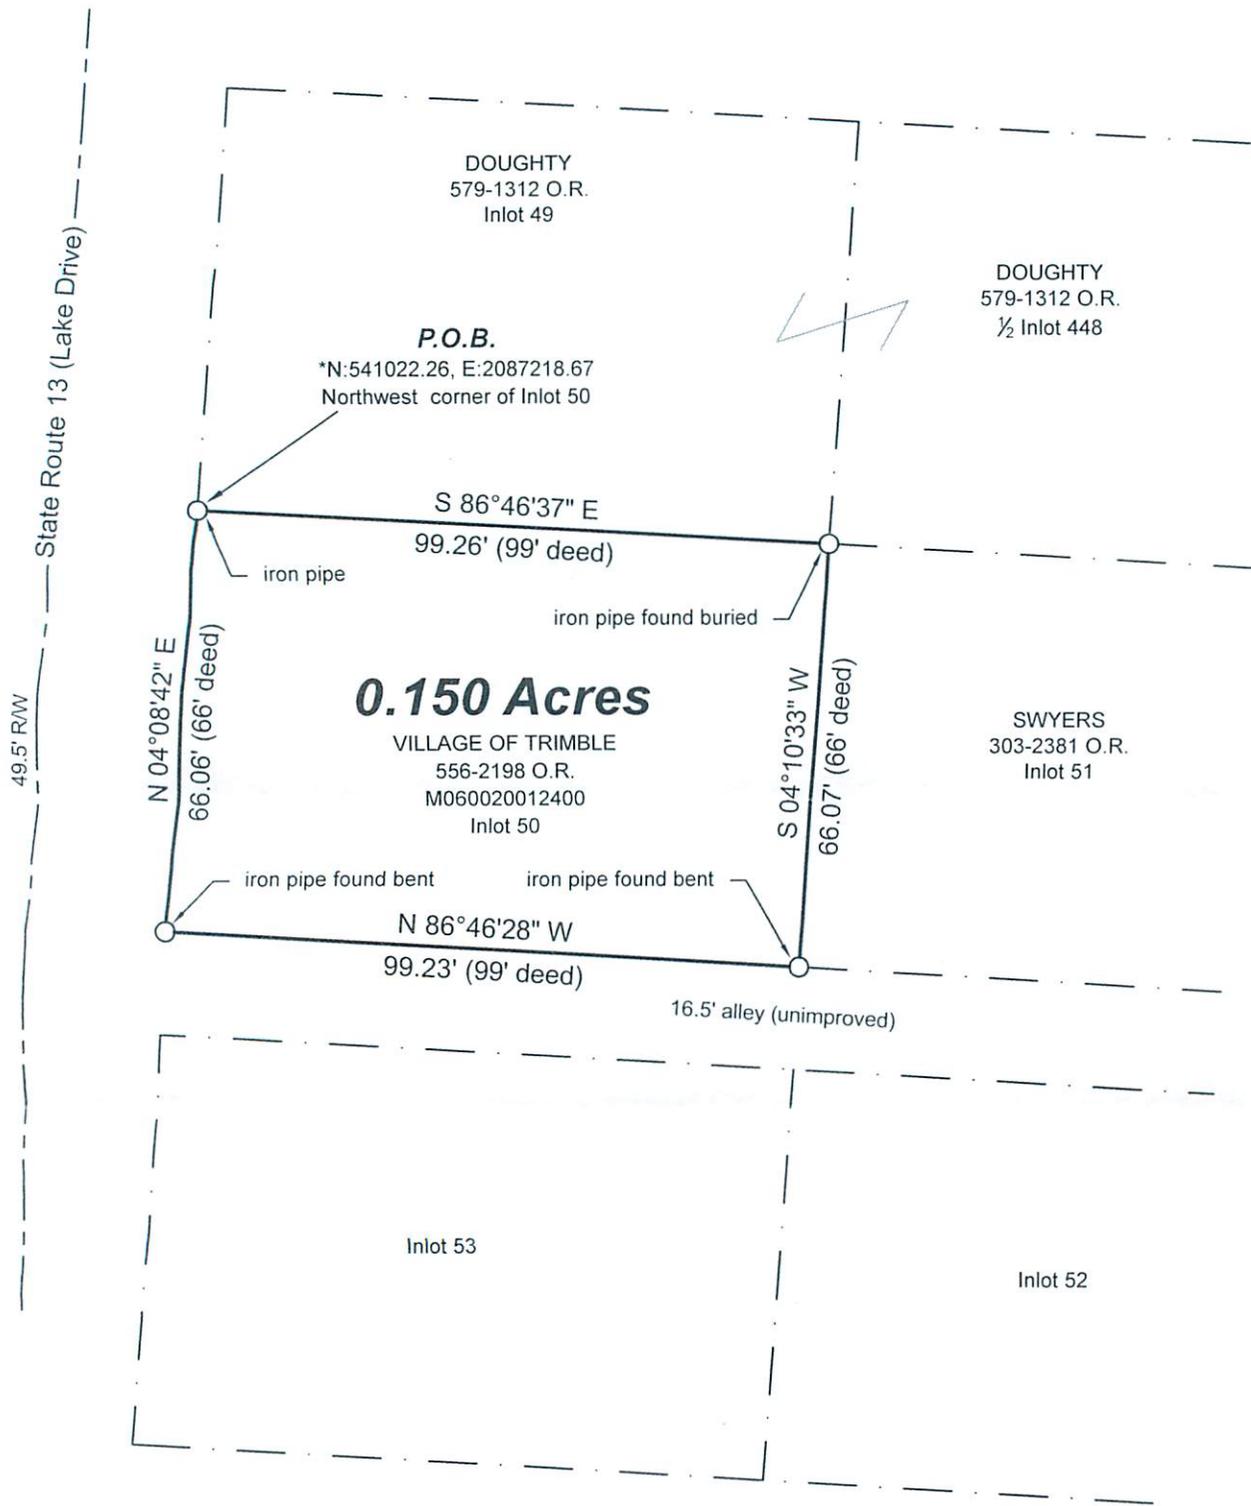

Scale 1"=30'

- = Iron pin set in concrete 5/8" rebar w/ plastic ID cap stamped Branner P.S. 6905
- = Iron pin found unless otherwise noted

Bearings: N.A.D. 83 - Grid North - Ohio South Zone
 Ref. Docs.: Tax Plats, Deeds, Existing Surveys
 J. Sand's Addition to the Town of Trimble, Env. 85D
 *Coordinates are to be used for GIS purposes only



Situated in J. Sand's Addition to the Town of Trimble, Section 8, T.11, R.14, Trimble Twp., Athens Co., OH
 Survey Completed April, 2023

By: 
 John M. Branner, P.S. 6805
 P.O. Box 274
 The Plains, OH 45780