


GLOUSTER OHIO
COUNTY OF
ATHENS

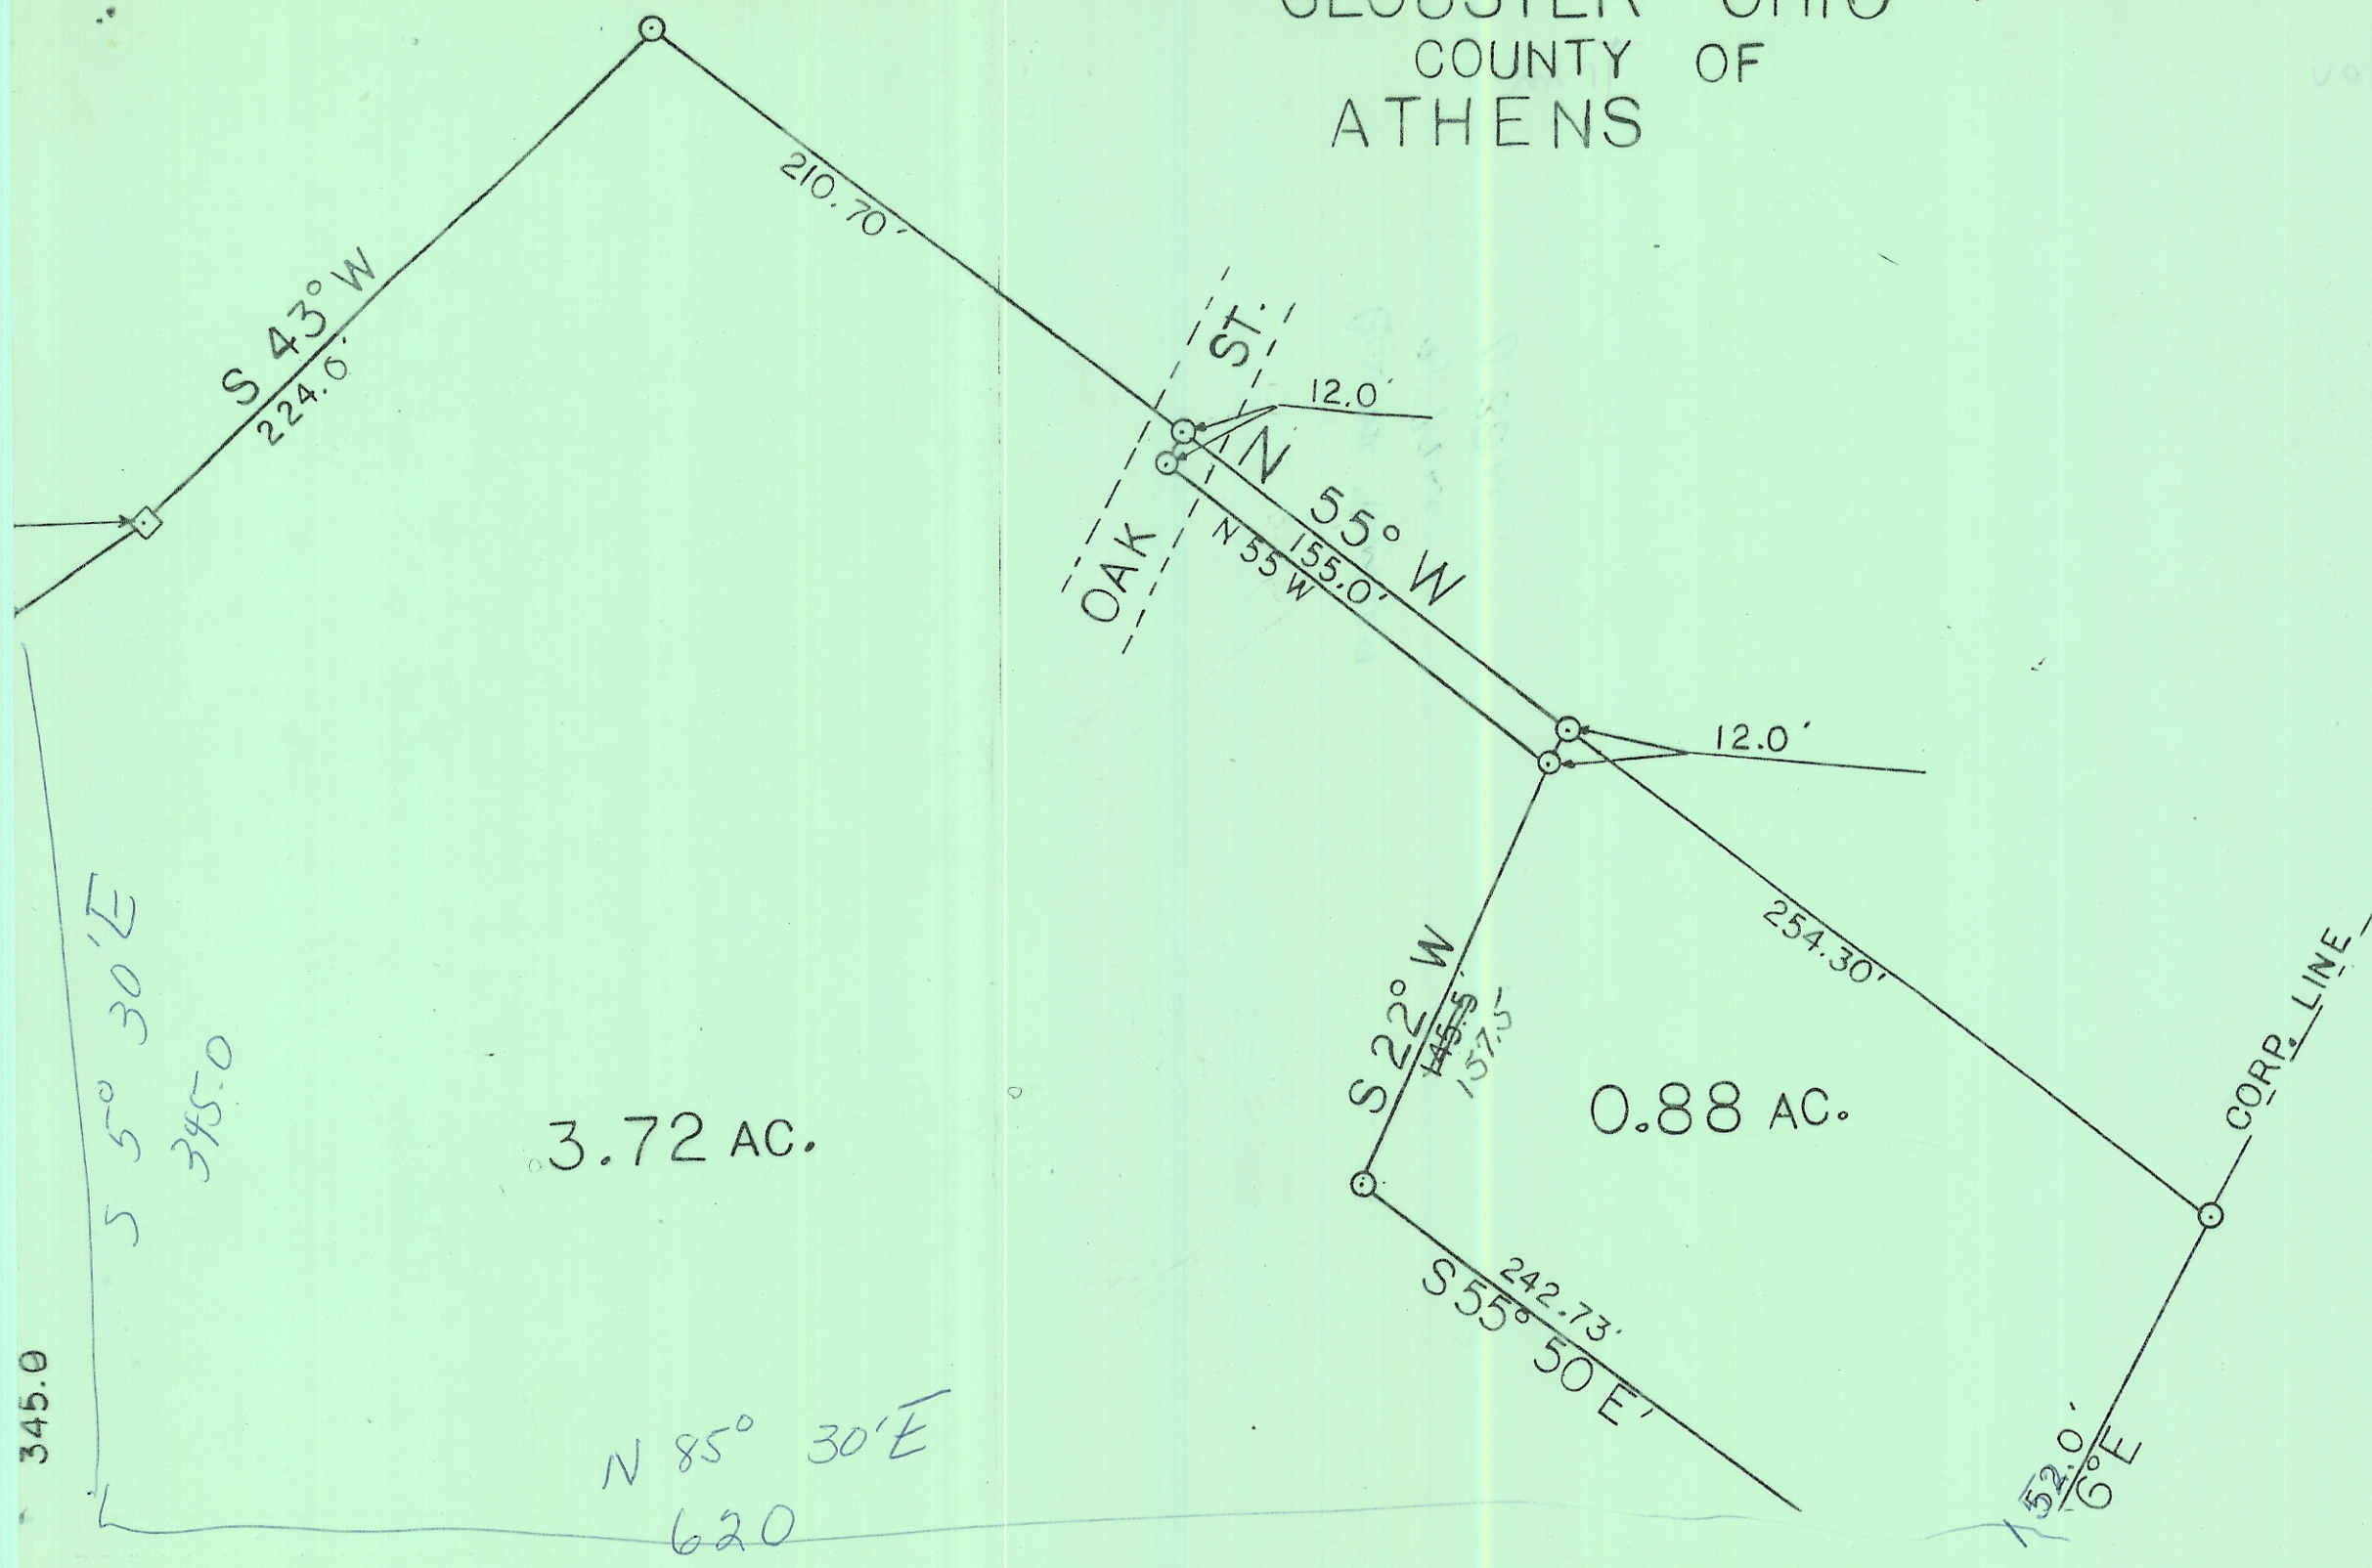

S 43° W
224.0'

210.70'

ST.
OAK
N 55° W
155.0'

12.0'

N 55° W
155.0'

12.0'

254.30'

3.72 AC.

0.88 AC.

CORP. LINE

S 5° 30' E
345.0

N 85° 30' E
620

S 22° W
157.5'

S 55° 50' E
242.73'

152.0' G° E

345.0