-scription checked to Mathematical Accuracy

MILLIAS COUNTY

"GINEER'S OFFICE

DESCRIPTION OF LOTS NO. 1,2,3,& 4 OF JAMES R. & GLORIA A. MORRIS

All that certain parcel of land situate in Section 19, Town 5, Range 11, in the Township of Troy, in the County of Athens and State of Ohio, more particularly bounded and described as follows:


described as follows:

LOT NO.1

Point of beginning being a nail in the center of Troy Township Road 163, a corner to James R. & Gloria A. Morris, W. J. & Doris Sinnett and W.W. Heiney, where a stone marking the center of Section 19 bears South 0°46'30" East 715.83 feet; thence with the center of Township Road 163 and the line of said Morris and Heiney, North 67°45' East 333.13 feet to a nail; thence leaving said Township road and the line of said Heiney, South 0°46'30" East 907.92 feet to a 5/8 inch iron pin set, passing two 5/8 inch iron pins set at 22.94 feet and 427.92 feet; thence South 89°13'30" West 310.00 feet to a 5/8 inch iron pin set in the line of George E. Heiney; thence with the lines of George Heiney and Sinnett, North 0°46'30" West 785.96 feet to the place of beginning, passing a stone found at 70.13 feet, marking the center of Section 19 and a corner to said Morris, Sinnett and George Heiney, and a 5/8 inch iron pin found at 765.63 feet.

Containing 6.027 acres more or less, as shown as Lot No.1 on the Plat of Survey attached hereto and made a part

Lot No.1 on the Plat of Survey attached hereto and made a part hereof by reference. LOT NO 2

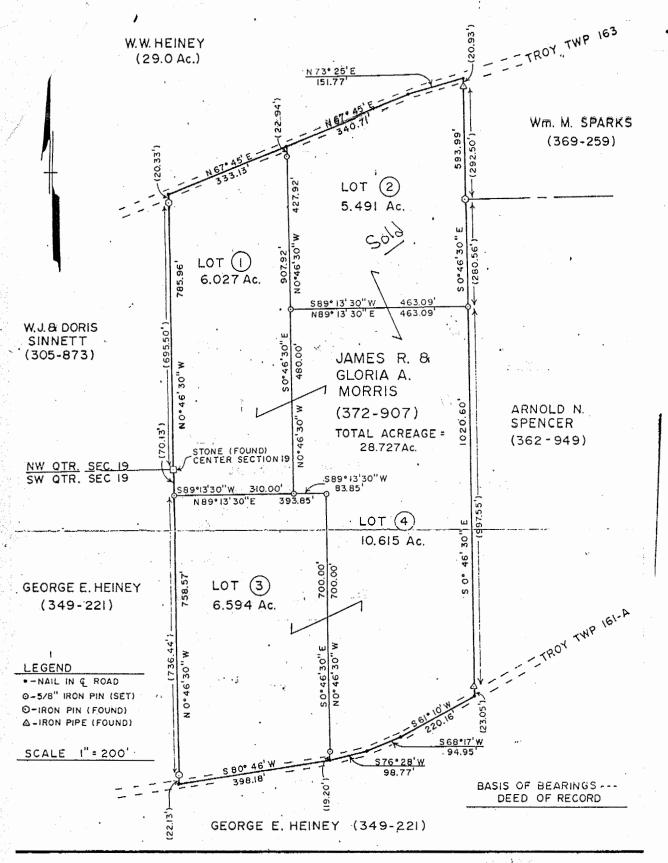

PLAT OF SURVEY OF

JAMES R. & GLORIA A. MORRIS
LOTS NO. 1,2,3,84

TROY TOWNSHIP, ATHENS COUNTY, OHIO SECTION 19, TOWNSHIP 5, RANGE II

SURVEYED APRIL 1983 BY TIMOTHY P. ROUSH UNDER THE SUPERVISION OF:



29