




# SOUTHEASTERN LAND SURVEYS

LEONARD F. SWOYER  
REGISTERED LAND SURVEYOR

Box 208A  
Route Five  
Athens, Ohio 45701  
614/593-8701

19

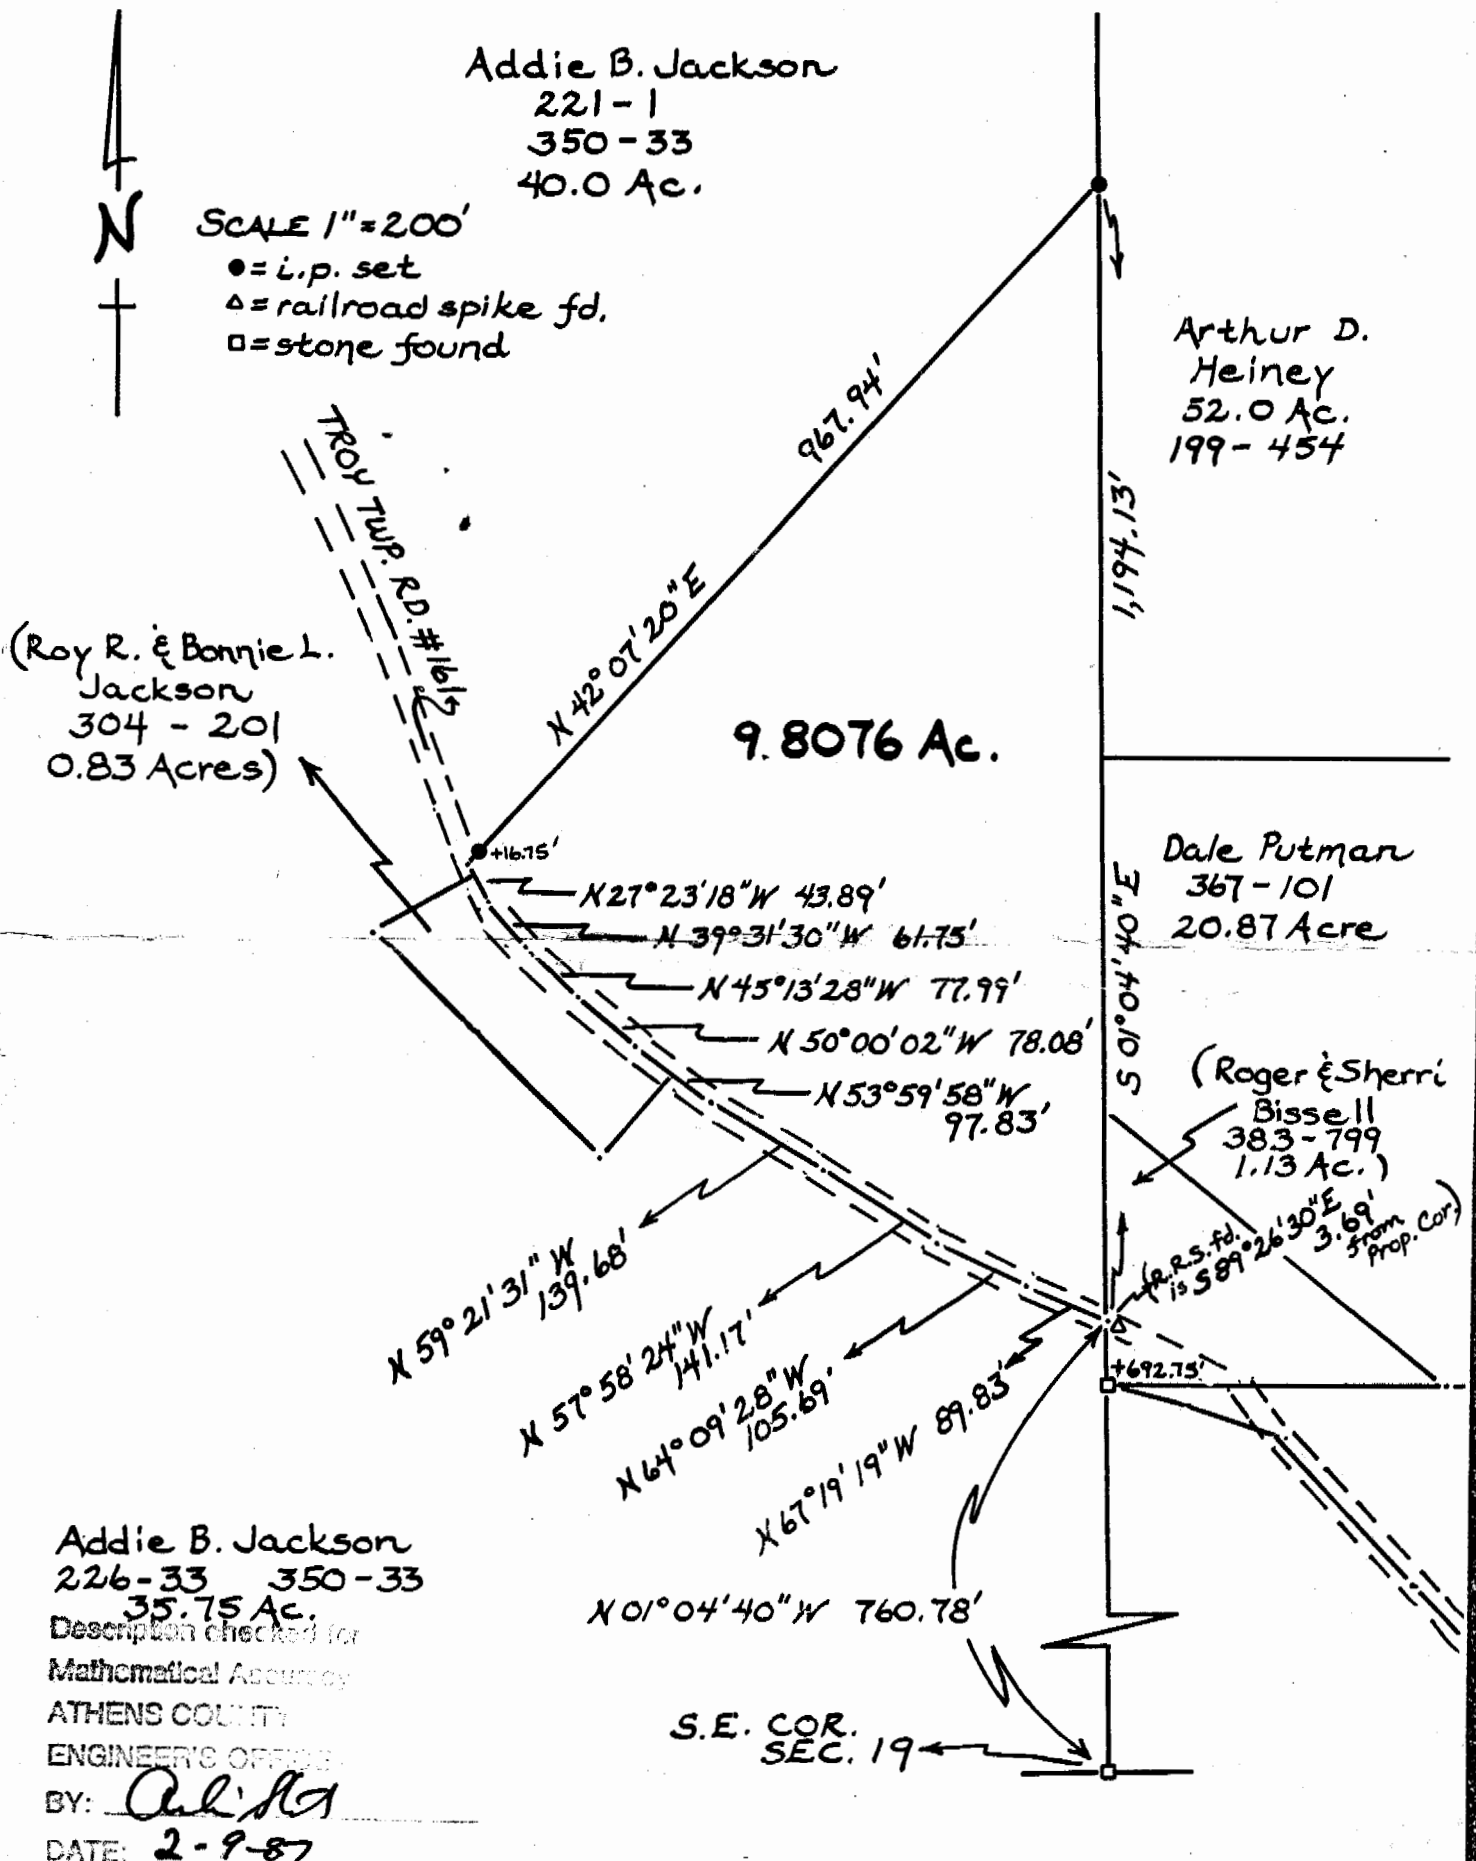

Addie B. Jackson  
 226-33 350-33  
 35.75 Ac.  
 Description checked for  
 Mathematical Accuracy  
 ATHENS COUNTY  
 ENGINEER'S OFFICE  
 BY: *Carl H. Swayer*  
 DATE: 2-9-87

Plat of a 9.8076 Acre Tract Scale 1" = 200'

Surveyed for Mr. Gary Jackson 1/17/87

Subdivision East 1/2 of the Southeast 1/4 of Sec. 19

Township Troy Section 19 Town 5N Range 11W

Corporation --- County Athens State Ohio

*Leonard F. Swayer II*  
 Leonard F. Swayer II Reg. Prof. Land Surveyor No. 6765

58

Troy 11 West