

H. RICHARDS

COUNTY HIGHWAY #62

S 90°00' E - 210.09'

SETBACK 20'

G. R. THOMPSON
38.39 AC.
220/314

1.001 ACRE

H. RICHARDS
100 AC.
333/921

N 2°53' W - 207.74'

*OK to transfer
Athens City to Health Dept
Dexter Conard, P.S.
9-14-90*


S 2°52' E - 207.74'

N 90°00' W - 210.06'

SETBACK 20'

BEGIN

E. DIXON
69.71 AC.
213/568
263/564

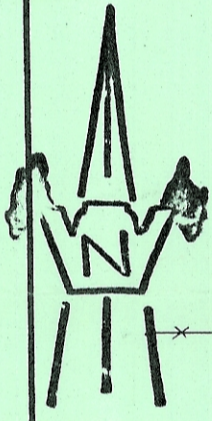

○ = IRON PIPE

DATE SURVEYED: 10/23/86

SCALE: 1" = 40'

PLAT OF 1.001 ACRES

Surveyed for HAROLD RICHARDS

Subdivision FRACTION #4

Township TROY Section 10, Town 5, Range 11

Corporation

County ATHENS

State OHIO

Chet Waterman
CHET WATERMAN, P. E.

Registered Surveyor #5319 (Ohio)
Registered Engineer #26389 (Ohio)
Registered Engineer #3788 (W. Va.)
Registered Surveyor #12 (W. Va.)
Invoice No. 86-817



References:

Four horizontal lines for references.