Morrison/Cunningham!

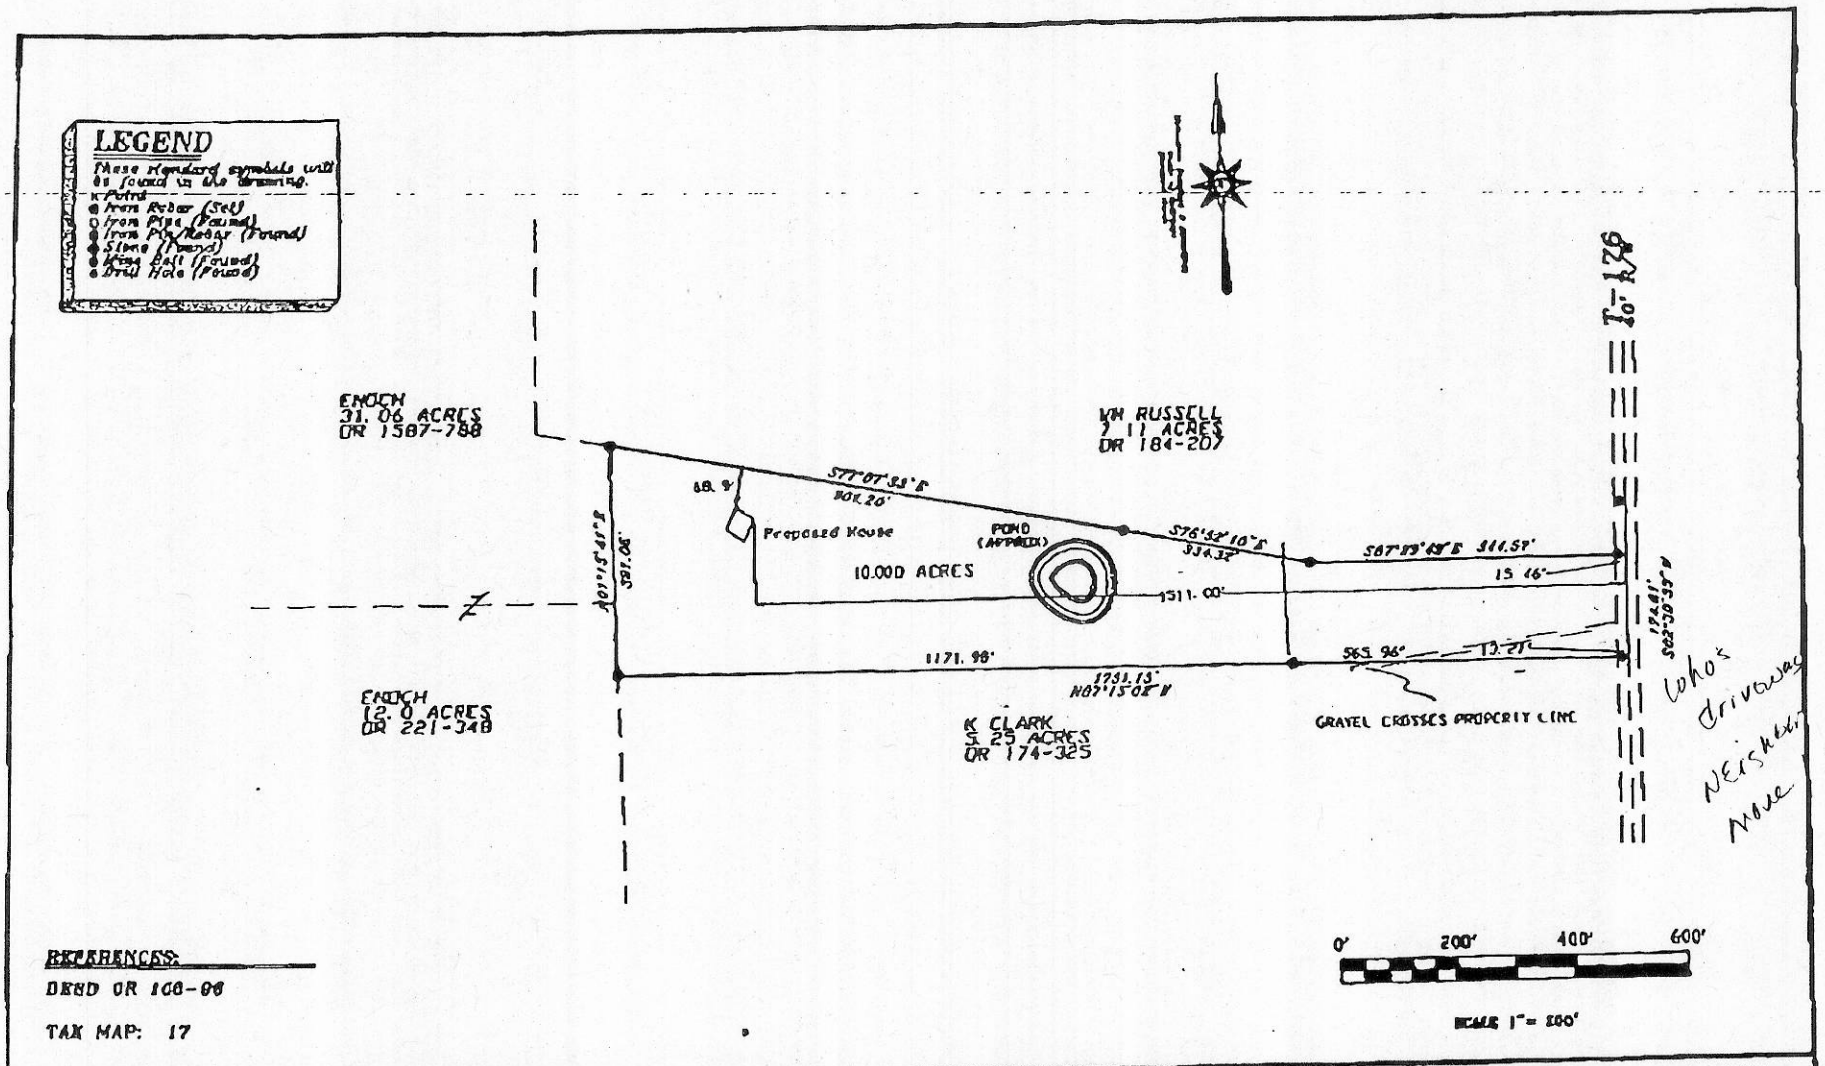

REFERENCES:

DEED OR 100-96

TAX MAP: 17

REV.	DATE	COMMENT
0	10/18/00	Revision to [illegible]

WELDON D. DOUGLASS P.S. #1286 OH; P.S. #1041 WV
WATERMAN-DOUGLASS AND ASSOCIATES
Engineers and Surveyors
4619 TOTEMAN ROAD, PARKERSBURG, WV 26102-6180
1-304-428-5718 1-304-483-4056 FAX

4365 BRANDEBERRY ROAD
Troy Township
Section 17, Town 5, Range 11
Athens County, Ohio

BOUNDARY SURVEY OF 10.000 ACRES
FOR: RUSSELL CUNNINGHAM &
RONALD MORRISON

PROJECT NO. [illegible]
DATE: 14/10/2000 SHEET 1 OF 1