


Sec. 21

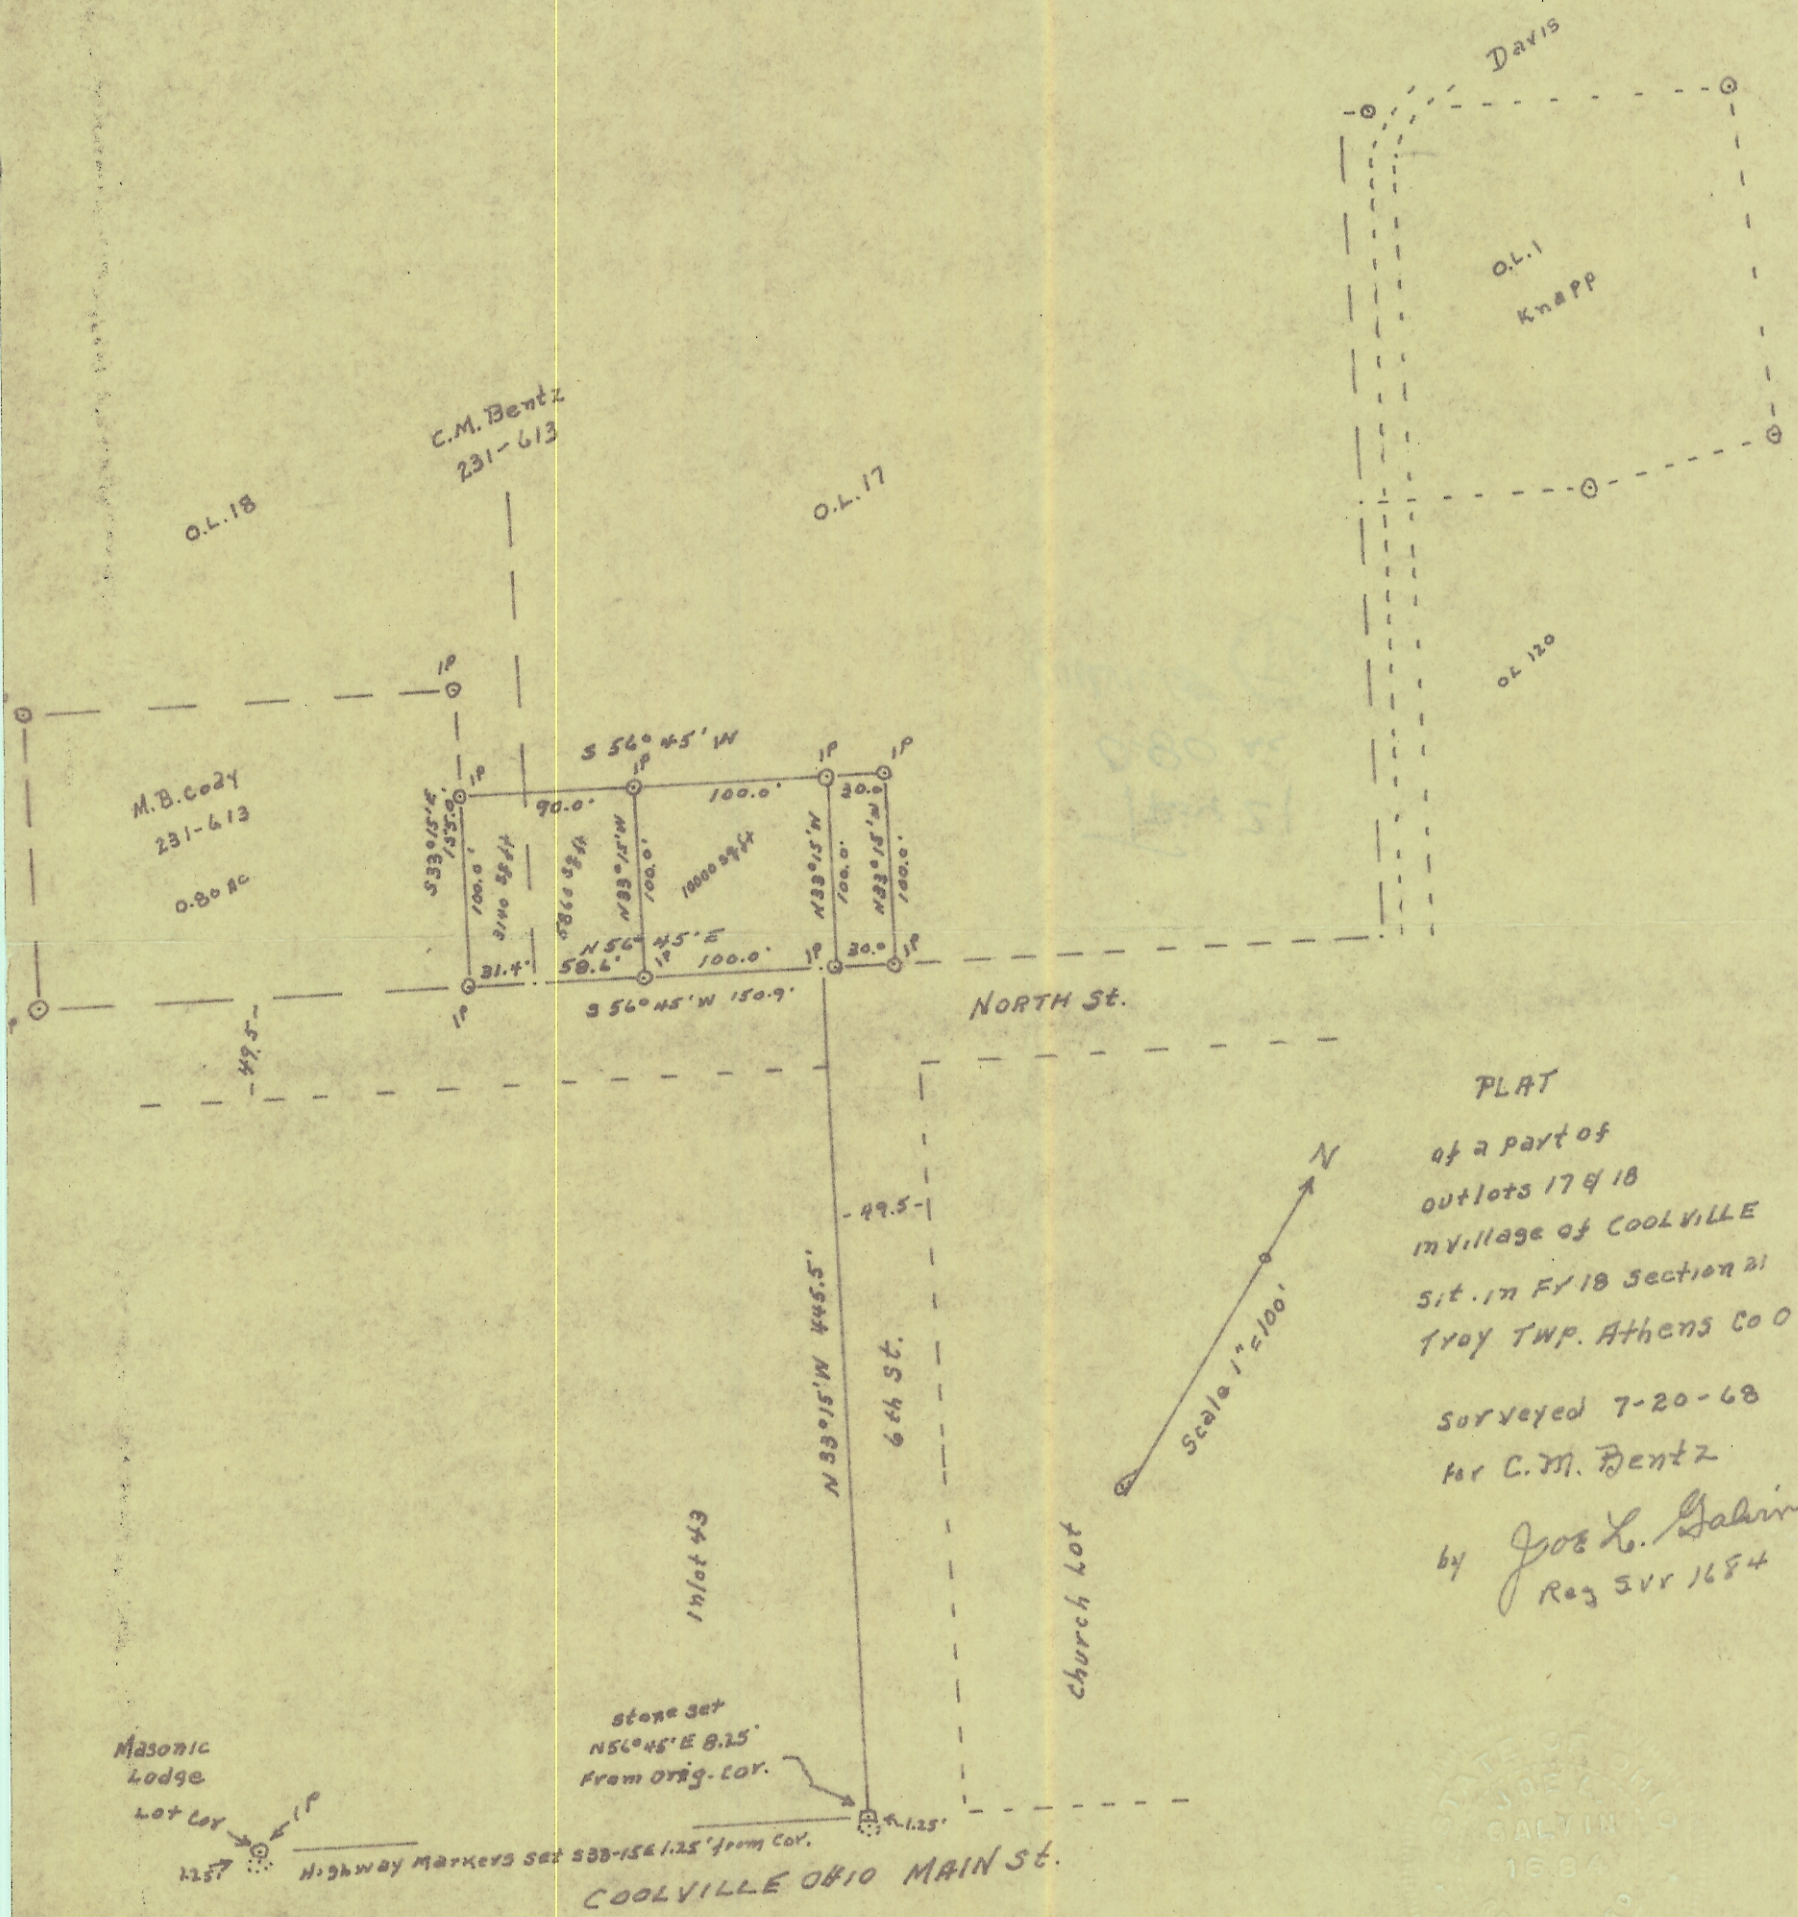

PLAT
 of a part of
 outlots 17 & 18
 in village of COOLVILLE
 Sit. in F/18 Section 21
 Troy Twp. Athens Co O
 Surveyed 7-20-68
 for C.M. Bentz
 by Joe L. Galvin
 Reg SVR 1684

