


Troy 31
5 TRACTS

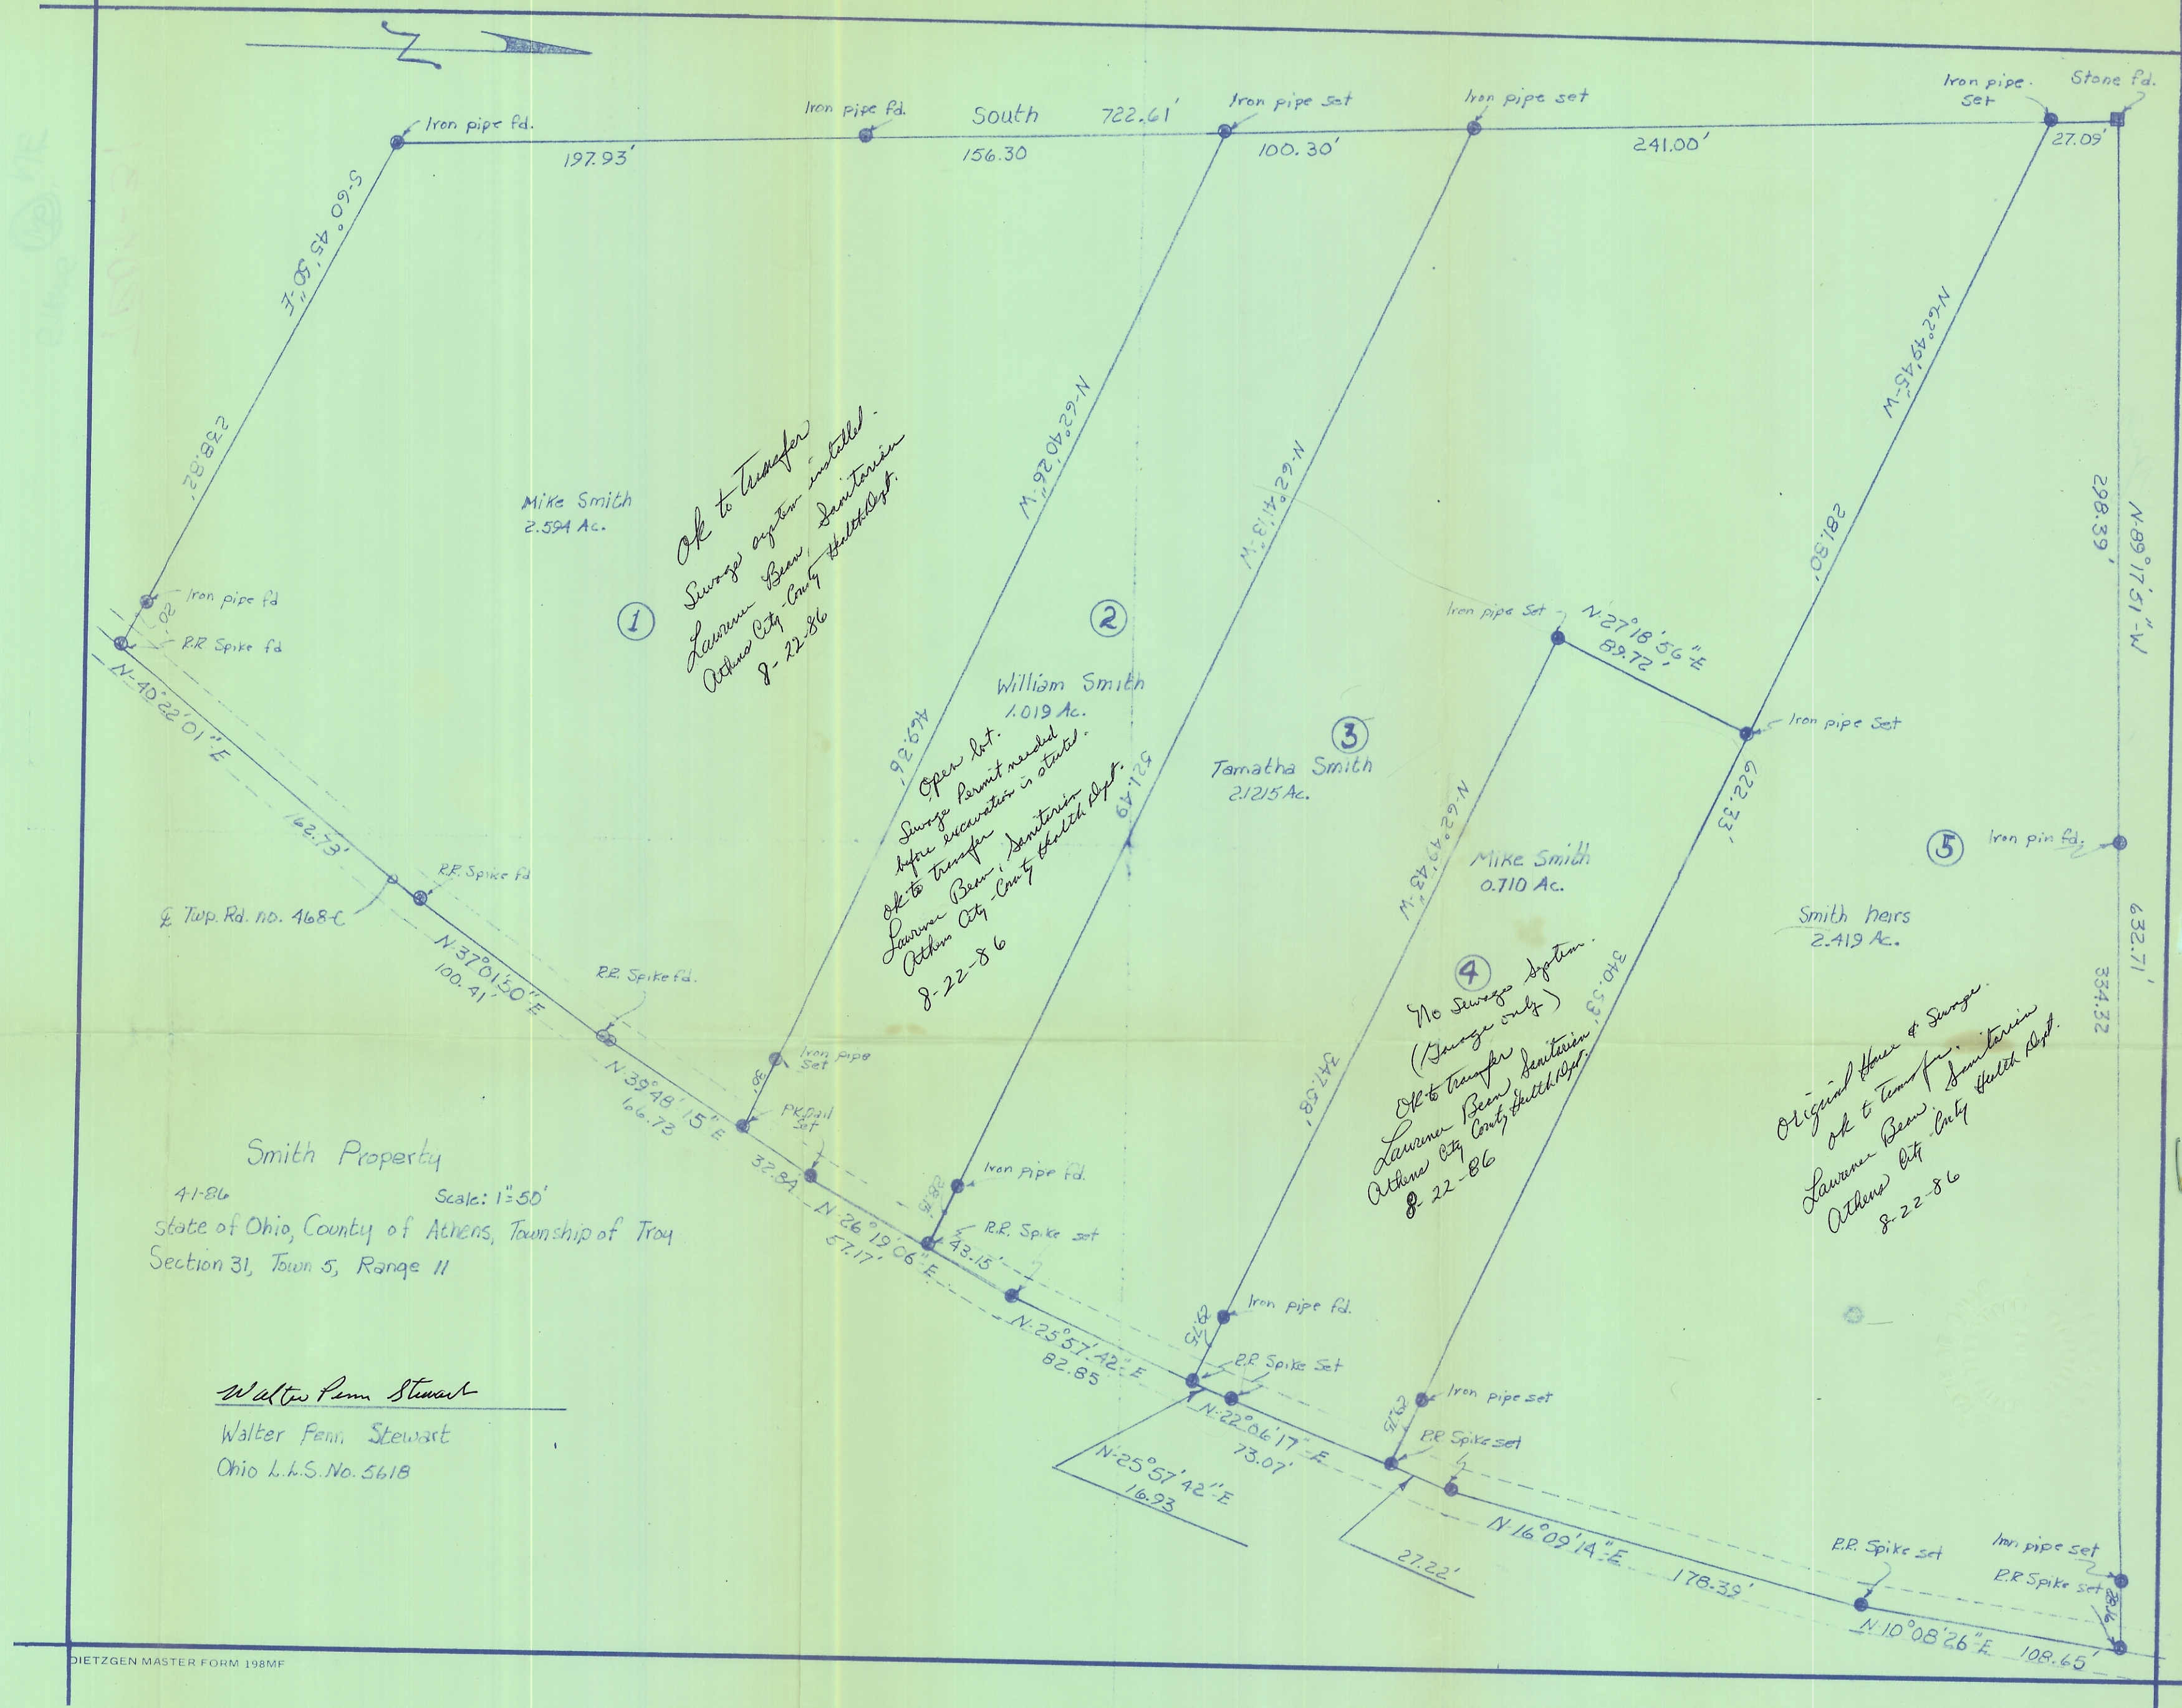

Mike Smith
2.594 Ac.

①
Ok to transfer
Sewer system installed.
Lawrence Bean, Sanitarian
Athens City, County Health Dept.
8-22-86

William Smith
1.019 Ac.

②
Open lot.
Sewer permit needed
before excavation is started.
Ok to transfer
Lawrence Bean, Sanitarian
Athens City, County Health Dept.
8-22-86

Tamatha Smith
2.125 Ac.

④
No Sewer system
(Garage only)
Ok to transfer
Lawrence Bean, Sanitarian
Athens City, County Health Dept.
8-22-86

Smith heirs
2.419 Ac.

⑤
Original House & Sewer
Ok to transfer
Lawrence Bean, Sanitarian
Athens City, County Health Dept.
8-22-86

Smith Property
41-86
State of Ohio, County of Athens, Township of Troy
Section 31, Town 5, Range 11

Walter Penn Stewart
Walter Penn Stewart
Ohio L.S. No. 5618