


Glen E. Thompson  
38.39 Ac.

S. 85°30'E  
1,452.00'

16.61 Acres

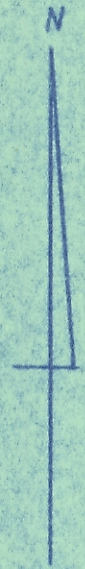

SCALE 1" = 100'

N 85°30'W  
1,452.00'

10.22 Acres

1,452.00'  
S 85°30'E

13.13 Acres

SURVEY OF A 13.13 ACRE TRACT, A 16.61 ACRE TRACT & A 10.22 ACRE TRACT  
IN THE S.W. QUARTER SEC. 4, T. 5 N, R. 11 W, TROY TOWNSHIP, ATHENS COUNTY, OHIO  
for CARL NUTTER

SURVEYED OCT. 15, 1971 by HAROLD D. WHALEY

*Harold D. Whaley*  
REG. SURV. NO. 4986

1,452.00  
N 85°30'W

SEC 4  
SEC 3

S.W. COR  
SEC. 4

Spik.  
NOTE: SPIKE  
AS SOUTH OF  
CORNER!

498.21  
498.76  
54.90 W

187.89' I.P. set  
18.51  
21.08  
N 65°55'40"E

1198.65  
120.54  
306.54  
SEC 4  
SEC 4  
SEC 4  
8 C.R. 62

36.08 I.P. set  
6.45  
57.53 W  
394.23

348.90

Spike Set 1.3 North  
of Sec. corner

498.21

306.84  
N 65°55'40" W

393.90