

Description of Parcel No. 7

Situated in the State of Ohio, County of Athens, Township of Troy, being in the northwest quarter of Section 5, Range 11 West, Township 5 North, of "The Ohio Company First Purchase of 1787", and being bounded and described as follows:

Commencing for reference at a railroad spike found in the top of a 24" diameter oak stump at the northwest corner of Section 5 (Note: Reference bearing on the west line of the northwest quarter of Section 5 used as South 00°55'28" West.);

thence, with the west line of Section 5 and the east line of a 74.88 acres tract as conveyed to Helen I. Russell by Official Records Volume 55, Page 439 of the Athens County Recorder's Office, South 00°55'28" West a distance of 841.50 feet to an iron pin set at the southwest corner of a 32.04 acres tract as conveyed to Gary P. Russell by Official Records Volume 208, Page 699 of the Athens County Recorder's Office;

thence, with the south line of occupation of said Russell property, the following three courses:

- (1) North 67°02'30" East a distance of 1,108.80 feet to an iron pin set;
- (2) thence North 81°23'24" East a distance of 759.75 feet to an iron pin set;
- (3) thence South 01°13'58" West a distance of 316.80 feet to an iron pin set, being THE TRUE POINT OF BEGINNING for this description;

thence, from said Point of Beginning continuing with the south line of said Russell property, South 89°10'15" East a distance of 270.00 feet to an iron pin set;

thence, leaving the property line, South 04°16'50" West a distance of 1,511.71 feet to a point in the centerline of Township Road No. 178, passing through three iron pins set at distances of plus 656.71 feet, plus 1,388.74 feet, and plus 1,488.74 feet, respectively;

thence, with the centerline of Township Road 178, the following three courses:

- (1) North 86°05'20" West a distance of 77.54 feet to a point;
- (2) thence North 87°27'29" West a distance of 112.19 feet to a point;

Description checked for
Mathematical Accuracy
ATHENS COUNTY

ENGINEER'S OFFICE

BY:

DATE:

Donna McLean
6-10-96

Page 2 of 2
Description of Parcel No. 7

(3) thence North 87°44'30" West a distance of 160.52 feet to a point;
thence, leaving the road, North 01°30'18" West a distance of 960.00
feet to an iron pin set, passing through an iron pin set at a distance
of plus 30.00 feet;

thence North 01°/3'58" East a distance of 538.26 feet to an iron pin
set;

thence South 89°10'15" East a distance of 206.36 feet to the Point of
Beginning;

containing 14.538 acres, more or less.

Subject to all legal right-of-ways, easements, restrictions,
reservations, and zoning regulations of record.

Subject to the right-of-way of Township Road No. 178.

Subject to the 100 year Flood Plain restrictions, if applicable.

Subject to a 50.00 feet wide easement being reserved unto the grantor,
his heirs, and/or assigns, forever. Said easement is for the purposes
of running utilities to other parcels of land on or near Township Road
No. 178. Said easement runs in an east-west direction across the
south end of the above described property with the south line of said
easement being the centerline of Township Road No. 178. Containing
0.402 acres, more or less, of easement.

All iron pins set are 1/2" x 30" rebar capped and labeled "Claus 6456".

The bearings in this description are for angle calculations only and
are based on the west line of the northwest quarter of Section 5 used
as an assumed bearing of South 00°55'28" West.

The above description prepared by Roger W. Claus, Registered Surveyor
No. 6456, based on a new survey of April 26, 1996, subject to any facts
that may be disclosed in a full and accurate title search.

Prior Deed: Official Records Volume 143, Page 449.

SURVEY PLAT

for

BRUNER LAND CO.

Situated in the State of Ohio, County of
ATHENS, Township of TROY,
 being IN THE NORTHWEST QUARTER
OF SECTION 5
 Range 11 West, Township 5 North, of "The
OHIO COMPANY FIRST PURCHASE - 1787."

PERTINENT DOCUMENTS

- (1) All deeds as shown.
- (2) County tax maps.
- (3) U.S.G.S. quadrangle map LUBECK.
- (4) Survey plat by CHET WATERMAN.
- (5) Survey plat by CHET WATERMAN.
- (6) Survey plat by CHET WATERMAN.
- (7)
- (8)
- (9) PRIOR DEED OR VOL. 143 PG. 449.

Subject to all legal right-of-ways, easements, restrictions, reservations, and zoning regulations of record. Subject to 100 year Flood Plain restrictions, if applicable. Subject to any facts that may be disclosed in a full and accurate title search.

- o = 1/2" iron pin set capped "Claus 6456".
- = iron pin found uncapped.
- = iron pin found capped "J.E. HUFFMAN 6452".
- = marked stone found.
- = un-marked stone found.
- △ = survey angle point.
- △ = railroad spike set.
- △ = railroad spike found.
- △ = tree with wire found.
- △ = existing property lines.
- △ = fence evidence found.
- △ = lines of this survey.


SURVEYOR'S CERTIFICATION

I HEREBY CERTIFY THAT THIS PLAT IS TRUE AND CORRECT TO THE BEST OF MY KNOWLEDGE AND THAT IT WAS PREPARED FROM AN ACTUAL FIELD SURVEY OF THE PREMISES.

5-26-96

Date	REVISIONS

Roger W. Claus, P.S. 6456
 33310 TH 2065
 Lewisville, Ohio 43754
 (614) 567-3168

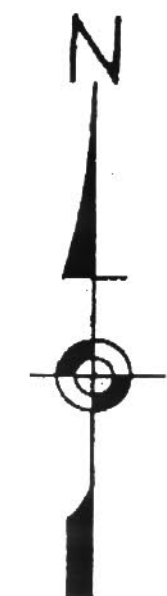

The bearings on this plat are for angle calculations only and are based on THE WEST LINE OF THE N.W. 1/4 OF SEC. 5 used as S 00°55'28" W.

SCALE 1" = 200 FT.



CLAUS SURVEYING
 ROGER W. CLAUS, P.S.
 (614) 567-3168
 33310 TH 2065
 Lewisville, Ohio 43754

LINE	BEARING	DIST.
A	N 86°26'41" W	148.89'
B	S 04°22'57" E	99.97'
C	S 67°47'03" W	149.10'
D	S 01°13'06" E	40.88'
E	S 01°13'06" E	20.00'
F	S 85°02'25" W	56.53'
G	S 77°10'27" W	50.21'
H	S 64°57'20" W	57.58'
I	S 53°48'22" W	57.75'
J	S 72°11'17" W	61.27'
K	S 31°28'04" W	163.77'
L	S 34°54'47" W	63.36'
M	S 76°51'43" W	34.83'
N	S 71°32'43" W	31.31'
O	S 89°15'43" W	33.15'
P	N 86°05'20" W	220.48'
Q	N 86°05'20" W	77.54'
R	N 87°27'29" W	112.19'
S	N 87°44'30" W	358.58'
T	N 86°34'06" W	188.68'
U	N 85°27'05" W	151.98'
V	N 86°35'00" W	407.60'
W	N 87°39'58" W	326.60'
X	N 82°43'05" W	170.65'
Y	N 79°43'35" W	99.80'
Z	N 76°36'09" W	54.16'

Gary P. & Patricia Russell
 32.04 AC.
 OR 208 P. 699

Helen I. Russell
 81.11 Ac. - Tax duplicate
 74.88 Ac. - Deed
 OR 55 P. 439

David M. &
 Rosemary Eaton
 86.46 AC.
 OR 170 P. 410

- (A) - David M. & Rosemary Eaton
 1.42 AC. V. 373 P. 1019
- (B) - John & Shelley Murphy
 1.0 AC. OR 80 P. 503
- (C) - John & Shelley Murphy
 0.36 AC. OR 141 P. 867

David & Beverly J. Wilfong
 Residue Tract
 OR 143 P. 449

RUSSELL

12 6
11 5

6 6
5 5

5 5
5 5

11 5
11 5

S.W. CORNER OF
 N.E.

QUARTER SEC. LINE

CENTER OF
 SEC. 5

SEC. 11
 SEC. 5

93

92

91

90