


I. PIPE WEST - 563.87' I. PIPE FENCE

FENCE 1231.28'

S 3° 02' E - 1892.88'

661.60'

N 3° 29' W - 2630.18'

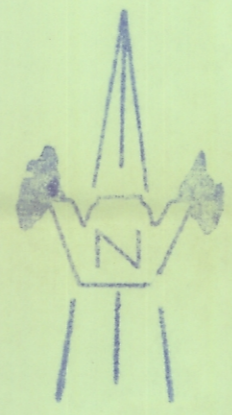

R. C. & JUNE ELLIS
159.48 ACRES
206 / 246 & 223 / 558

J. W. & NELLIE CAMPBELL
57.12 ACRES
234 / 191

ROBERT C. & JUNE ELLIS
40.11 ACRES

V. & P. DUNFEE
86 ACRES
189 / 289

STONE
FENCE
N 00° 15' E - 1372.17'

PRIVATE ACCESS ROAD
I. PIPE
S 85° 30' W 216.14'
POINT
S 26° 30' W - 376.18'
I. PIPE PRIVATE ROAD
POINT
S 84° 30' W 276.52'

SECTION 5
SECTION 4

B. & O. RAILROAD
S 61° 01' E - 467.65'

S 87° 33' E 112.00'
I. PIPE
S 50° 38' E - 73.10'
S 50° 27' E - 23.99'
S 61° 01' E - 50.00'
BEGIN
N 74° 26' E - 599.93'

ROUTE 50
LIMITED ACCESS (RIGHT-OF-WAY ONLY)
1722.73'

STONE
S. E. CORNER OF THE
QUARTER OF
SECTION 5

ROBERT C. & JUNE ELLIS
40.11 ACRES
(0.18 AC. IN SECTION 4 & 39.93 AC. IN SECTION 5)
T 5 N , R 11 W
TROY TOWNSHIP
ATHENS COUNTY , OHIO
SCALE: 1" = 200' DATE: 10 / 17 / 78

E. M. RUSSELL
29 ACRES
138 / 600

R. C. & JUNE ELLIS
14.1 ACRES
206 / 246 & 223 / 558



Chet Waterman
CHET WATERMAN, P.E., L.S.
L.S. 5319
JOB NUMBER: 78003-542