Description Checked for Mathematical Accuracy Athens County ENGINEER'S OFFICE

BY: Teranh Will DATE: \_\_\_\_\_\_ 12/17/15

OHIO FRANKLIN REALTY, LLC
POSTON COAL LANDS
WATERLOO TOWNSHIP
ATHENS COUNTY, OHIO
ENCROACHMENT TO AUCTION PARCEL

Legal Description Pre-Approval
APPROVED

All transfers are subject to Athens County Conveyance Standards

JAN 05 2016

KRIVESTI ENCROACHMENT: 1.512 ACRE

Jill Thompson Athens County Auditor

Situated in the State of Ohio, County of Athens, Township of Waterloo, bounded and described as follows:

Being a part of the Southeast Quarter of Section 6, Township 11, Range 15, Ohio Company Lands, being part of AEP Parcel 102-B-30, within lands now owned by Ohio Franklin Realty, LLC (DR 503-2282), and more particularly described as follows:

Beginning for reference the Southeast corner of Section 6, Waterloo Township, T-11, R-15, Athens County, Ohio;

thence along the centerline of Salem Road (CR-9), North 02 degrees 30 minutes 40 seconds East 555.54 feet to an iron pin found on the southeast corner of lands now owned by Michael J. Krivesti (DR 363-575);

thence along Krivesti's south line and the south line of lands now owned by Michael J. and Sondra K. Krivesti (DR 413-1955), North 86 degrees 50 minutes 09 seconds West 359.45 feet to a pipe found and the principal place of beginning, passing an iron pin found at 30.45 feet;

thence through said lands now owned by Ohio Franklin Realty, LLC (DR 503-2282) the following three courses:

- 1) North 86 degrees 50 minutes 09 seconds West 190.01 feet to an iron pin set;
- 2) North 03 degrees 39 minutes 30 seconds East 347.42 feet to an iron pin set;
- 3) South 86 degrees 20 minutes 40 seconds East 190.00 feet to an iron pin found on said Michael J. and Sondra K. Krivesti land;

thence along said Krivesti land, South 03 degrees 39 minutes 30 seconds West 345.79 feet to the principal place of beginning, passing an iron pin found at 108.87 feet, containing 1.512 acres, more or less.

Subject to all easements and right of ways, written or implied.

Bearings are based on the Ohio State Plane Coordinate System, South Zone, North American Datum 1983, as per GPS observations made May 11, 2015.

This description is written based on field and record data and completed May 15, 2015 by Linn Engineering, Inc.

Timothy H. Linn, PS


Parcel No.

Part of: N020020003000

 $(\pm 1.512 ac.)$ 


The above described parcel is to be held continuous and contiguous with Auditor's Parcel Number N020020002701.

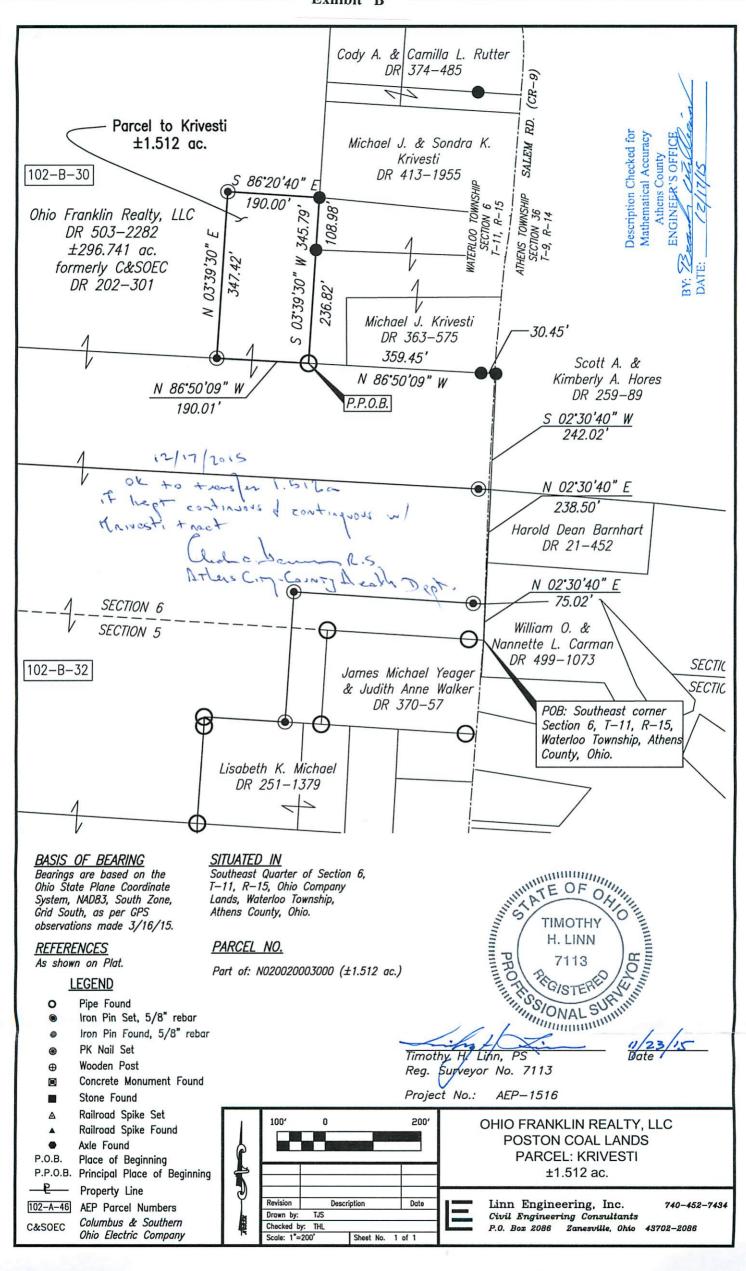



## LOTSPLIT/LAND TRANSFER PERMIT

## CITY OF ATHENS, OHIO ATHENS CITY CODE TITLE 23

Permit #: LS15-000022

Issue Date: 12/29/2015

Permit Type: Minor Issue Dat			2/29/2015	
Description: Encroachment by	11135 Salem Rd. o	onto AEP property and ne	eds to be continuous and	contiguous.
Approval Conditions/Notes: Yo Code Title 21.	our request for a lo	tsplit is approved in accor	dance with the application	submitted, Athens City
Location:				
Lot: Section: 6	Town: 11	Range: 15	Township: Waterloo	).
Applicant: Ohio Franklin Realty				
Phone: (740)962-1214				
Property Owner:				
Ohio Franklin Realty Phone: (740)962-1214			11135 Saler Athens OH	
Surveyor Name: Linn Engineer	ing Inc.			
			Registratio	n #:
Date property owner originally p	urchased the prope	erty:		2/01/2014
Acreage of original purchase:			2	96.741
Number and size of parcels subdivided since original purchase:				540
Acreage of proposed parcel(s) with new plat of survey attached:  Public road frontage of proposed parcel(s):				.512
Date of survey of plat of proposed parcel(s):				esidual: 295.229 1/01/2015
Approval date of health authority of jursidiction for sewage disposal:				
Approval date of County Engineer for mathmatical accuracy of survey:			1	2/17/2015
Minimum Requirements:				
Public Road Frontage:		Engineer's A	pproval: 🗹	
Width to Depth Ratio: ✓ Health Depa		rtment Approval: 🗹		
Number of Splits Permitted: 🗹		Registered S		
Total Fees: \$80.00				
Service-Safety Director recomi	mendation:			
[X] Approved	[ ] Refused			
Paula Harrin 1		1/4/112		
Paula Horan-Moseley Service-Safety Director			Date	