

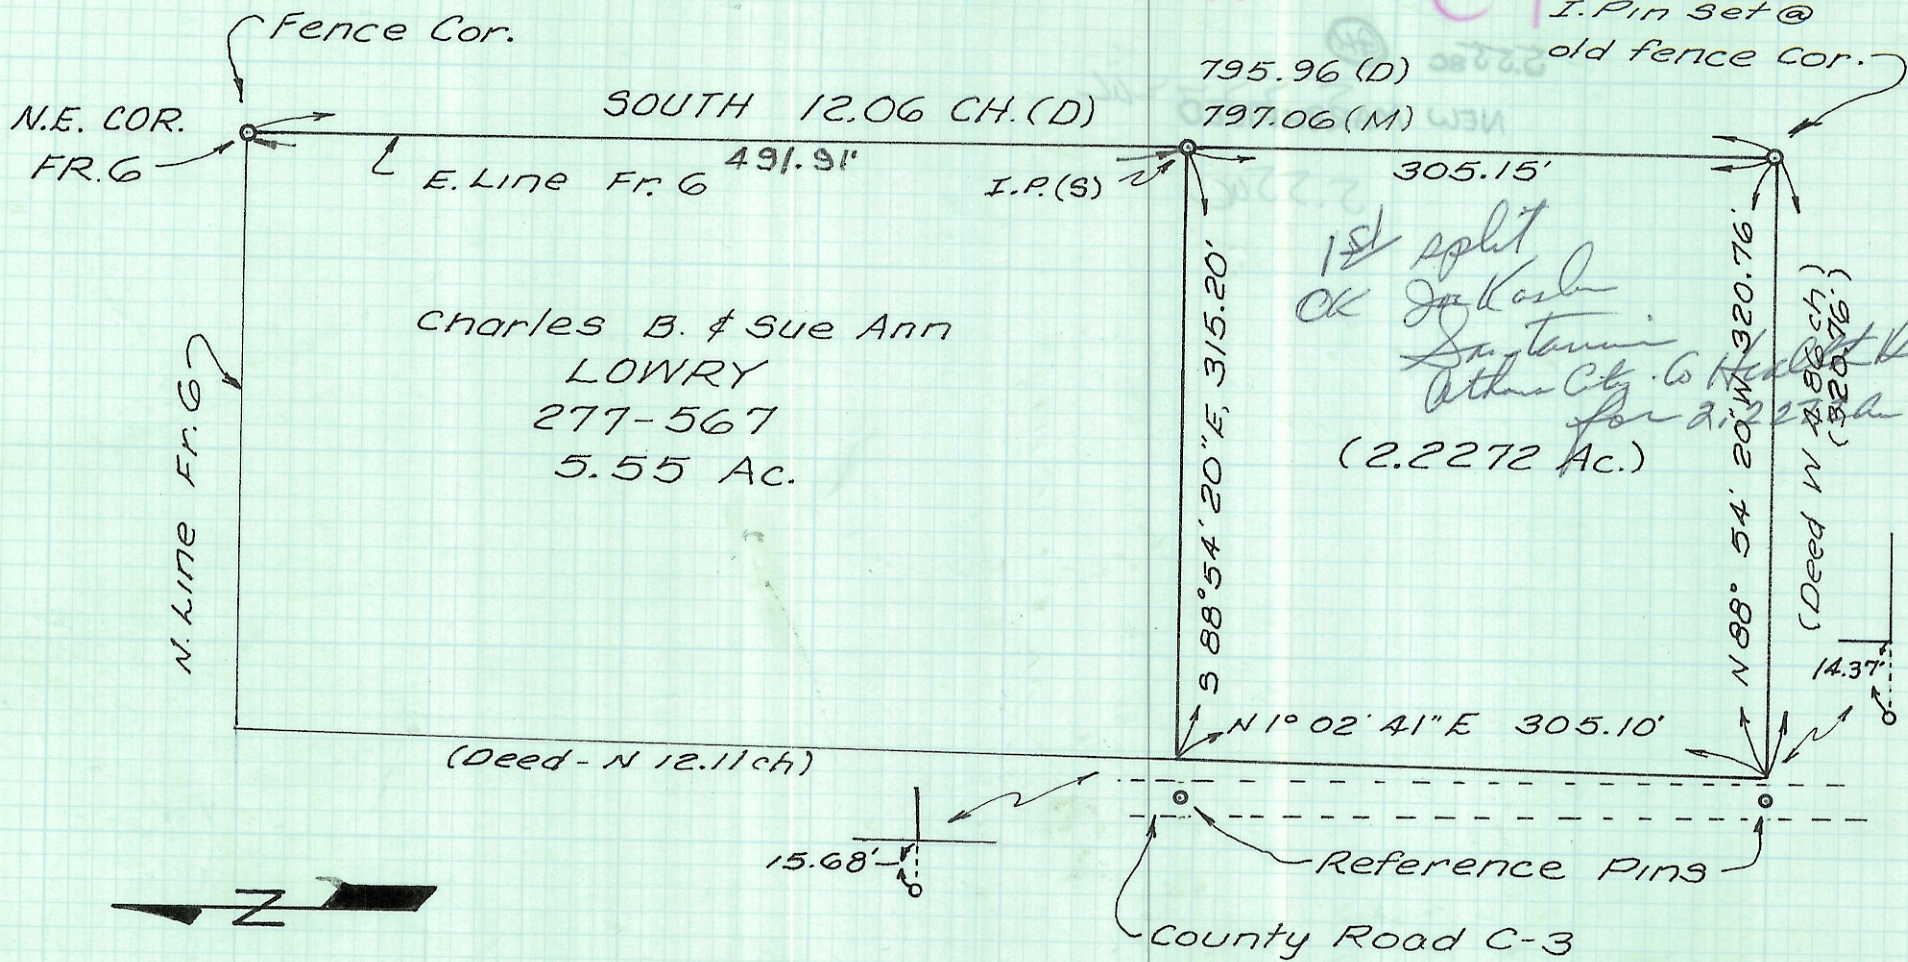


LOW 21

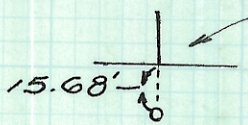

Charles B. & Sue Ann
 LOWRY
 277-567
 5.55 Ac.

1st split
 OK Jack Kasler
 Dan Tamm
 Athens City. Co. Health Dept
 for 2.2272 Ac.
 (2.2272 Ac.)

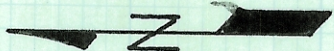

STATE OF OHIO
 GERALD E. HANN
 SURVEYOR
 Athens, Ohio

Gerald E. Hann
 5-5062

<p>MAY 1978 1" = 100'</p>	<p>Survey For Charles B. & Sue Ann Lowry New Marshfield, Ohio By Gerald E. Hann Athens, Ohio</p>	<p>FR 6, T-11 R-15 (SEC 15) Waterloo Twp. Athens County Ohio</p>
--	--	--