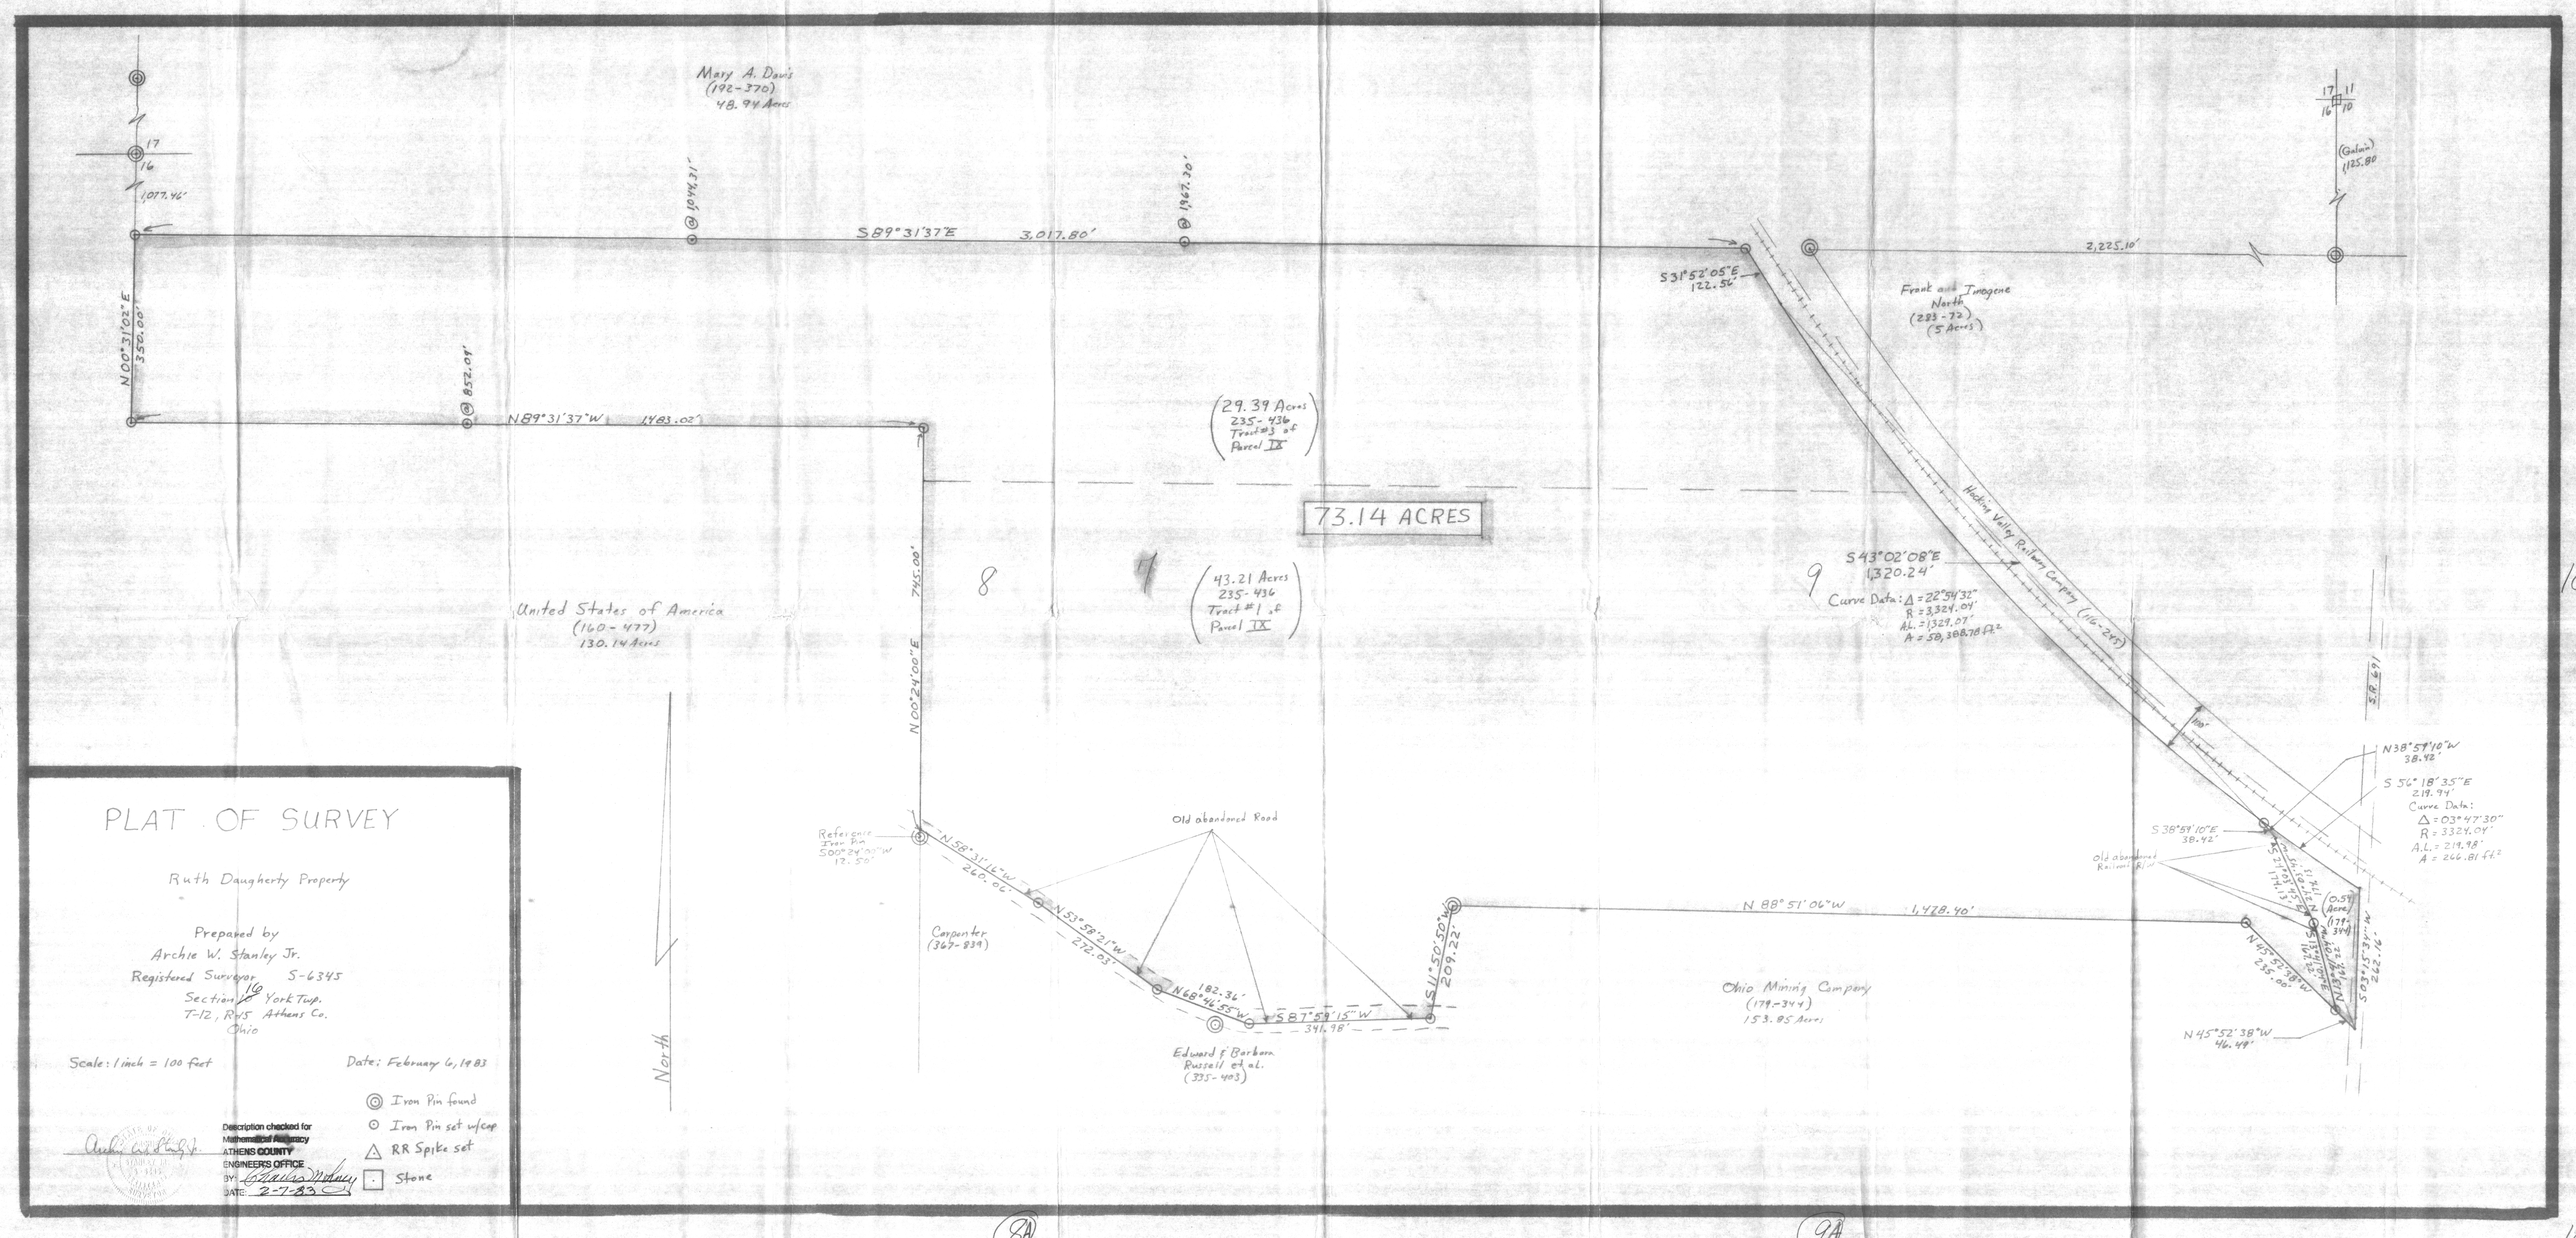
Mary A. Davis
(192-370)
48.94 Acres
17
16
1,077.46'
@ 1094.31'
@ 1967.30'
S89°31'37"E 3,017.80'
N00°31'02"E 330.00'
@ 852.01'
N89°31'37"W 1483.02'
(29.39 Acres
235-436
Tract #3 of
Parcel IX)
73.14 ACRES
(43.21 Acres
235-436
Tract #1 of
Parcel IX)
8
9
United States of America
(160-477)
130.14 Acres
N00°24'00"E 745.00'
S31°52'05"E
122.56'
Frank and Imogene
North
(283-72)
(5 Acres)
2,225.10'
17
16
11
10
(Galvin)
1,125.80
Hocking Valley Railway Company (116-249)
S43°02'08"E
1,320.24'
Curve Data: Δ = 22°54'32"
R = 3,324.01'
A.L. = 1329.07'
A = 58,388.78 ft²
S.R. 691
100'
N38°59'10"W
38.42'
S 56°18'35"E
219.94'
Curve Data:
Δ = 03°47'30"
R = 3324.01'
A.L. = 219.98'
A = 266.81 ft²
S38°59'10"E
38.42'
Old abandoned
Railroad R/W
N 88°51'06"W 1,478.40'
(0.54
Acres
(174-
3 344)
N45°52'38"W
235.00'
N45°52'38"W
46.49'
N 16°43'22"E
174.73'
Ohio Mining Company
(179-344)
153.85 Acres
Old abandoned Road
Reference
Iron Pin
S00°24'00"W
12.50'
N 58°31'15"W
260.06'
N 53°58'21"W
272.03'
Carpenter
(369-839)
N68°46'55"W
182.36'
S87°59'15"W
341.98'
S11°50'50"W
209.22'
Edward & Barbara
Russell et al.
(335-403)
North
PLAT OF SURVEY
Ruth Daugherty Property
Prepared by
Archie W. Stanley Jr.
Registered Surveyor S-6345
Section 16 York Twp.
T-12, R-15 Athens Co.
Ohio
Scale: 1 inch = 100 feet
Date: February 6, 1983
Iron Pin found
Iron Pin set w/cap
RR Spike set
Stone
Description checked for
Mathematical Accuracy
ATHENS COUNTY
ENGINEERS OFFICE
BY: Charles Mowery
DATE: 2-7-83