Sec 12
York

Sec. 12

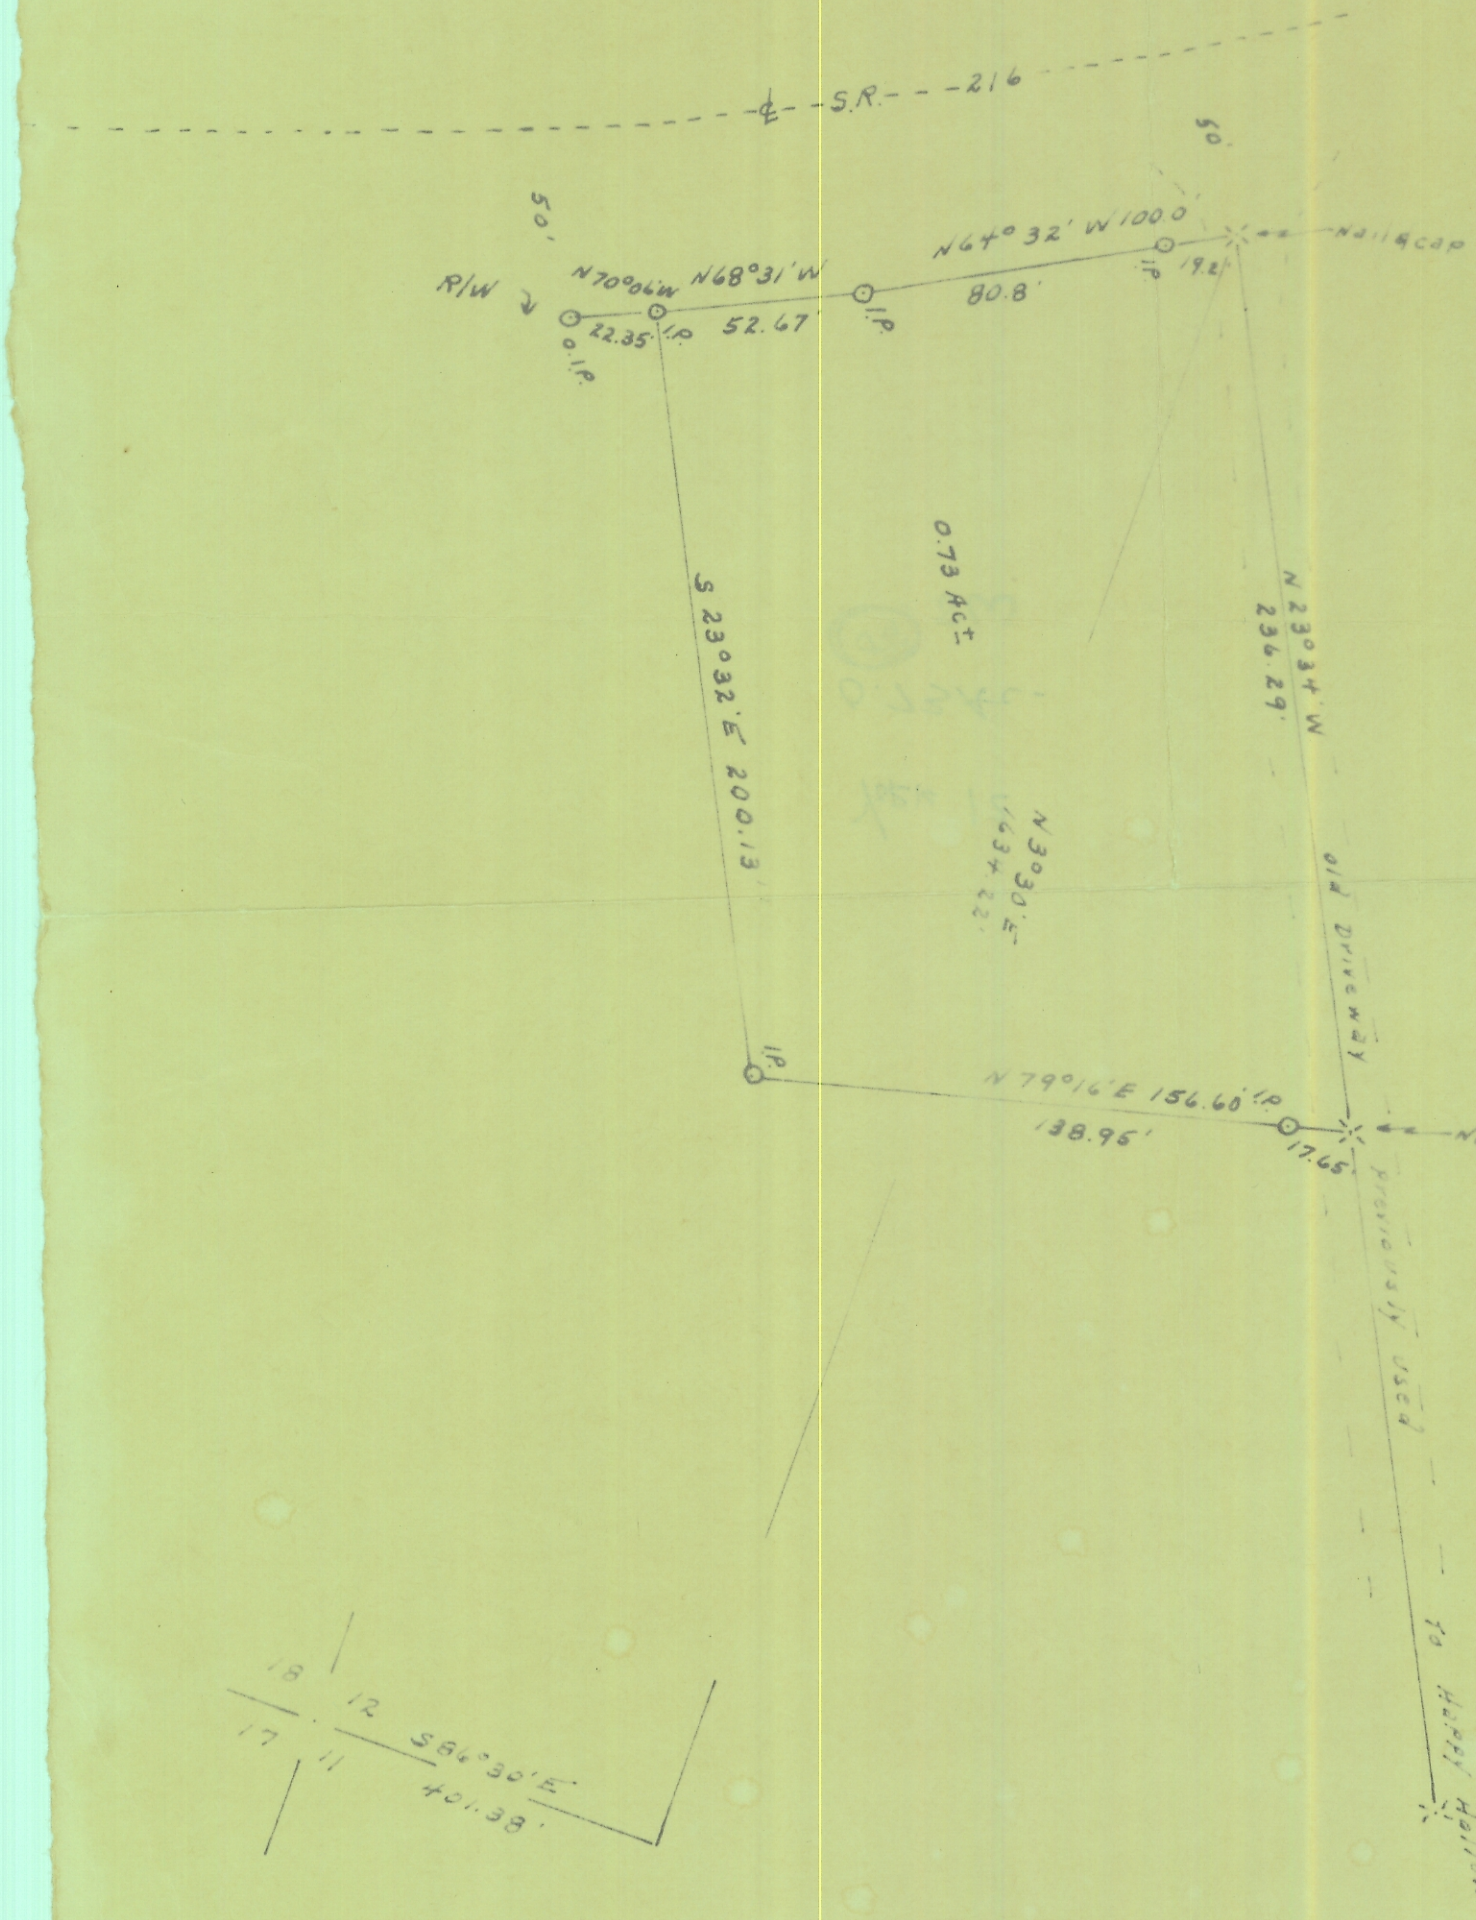

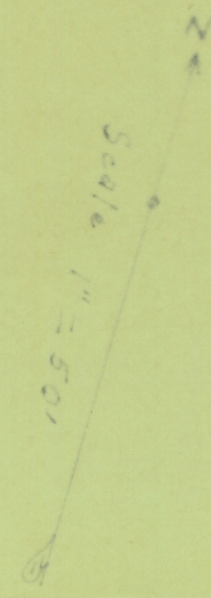

PLAT
of a part of Section 12
Town 12 Range 15 York
Township, Athens County
Ohio and in the City of
Nelsonville Ohio

surveyed for Roy Backus
July 1965
by Joe L. Galvin
Reg. Sur. 1684.